

SYSTEM INVERT SCHEDULE

DESCRIPTION	PROPOSED	AS-BUILT
BLDG INV	298.3	299.15
TANK (IN)	297.9	298.9
TANK (OUT)	297.6	298.7
P.C. (IN)	297.6	298.0
P.C. (OUT)	297.4	297.2
D-BOX (IN)	311.8	311.5
D-BOX (OUT)	311.6	311.22
END LINE 1	310.9	310.8
END LINE 2	310.9	310.9
END LINE 3	310.9	310.9


THIS IS TO CERTIFY THAT GLM ENGINEERING CONSULTANTS INC. DID, ON 10/08/20 INSPECT THE FINAL GRADING FOR THE SEWAGE DISPOSAL SYSTEM SHOWN ON THIS PLAN AND FOUND IT TO BE IN SUBSTANTIAL COMPLIANCE WITH THE TERMS OF THE PERMIT, THE REQUIREMENTS OF THE BOARD OF HEALTH, THE REQUIREMENTS OF THE COMMONWEALTH OF MASSACHUSETTS TITLE 5 AND OF THE APPROVED SEWAGE DISPOSAL PLAN.

THIS FIRM DID ON 10/08/20 INSPECT THE SEWAGE DISPOSAL SYSTEM, AND FOUND IT TO BE SUBSTANTIALLY LOCATED AND CONSTRUCTED IN COMPLIANCE WITH THE TERMS OF THE PERMIT, THE REQUIREMENTS OF THE BOARD OF HEALTH, COMMONWEALTH OF MASSACHUSETTS TITLE 5 AND THE APPROVED SEWAGE DISPOSAL PLAN DATED MAY 1, 2019.

SYSTEM SIZING CALCULATIONS:

THE SYSTEM INSTALLED IS A BED CONFIGURATION.

GARBAGE GRINDER: NO
FLOW REQUIRED = 859 G.P.D. + 0 G.P.D. = **859 G.P.D.**
LEACHING AREA PROVIDED:
BED: 42' x 62' = 2,170 S.F.
FLOW PROVIDED = LEACHING AREA x SOIL COEF.
FLOW PROVIDED = 2,170 S.F. x 0.60 GAL/S.F. = **1,300 G.P.D.**

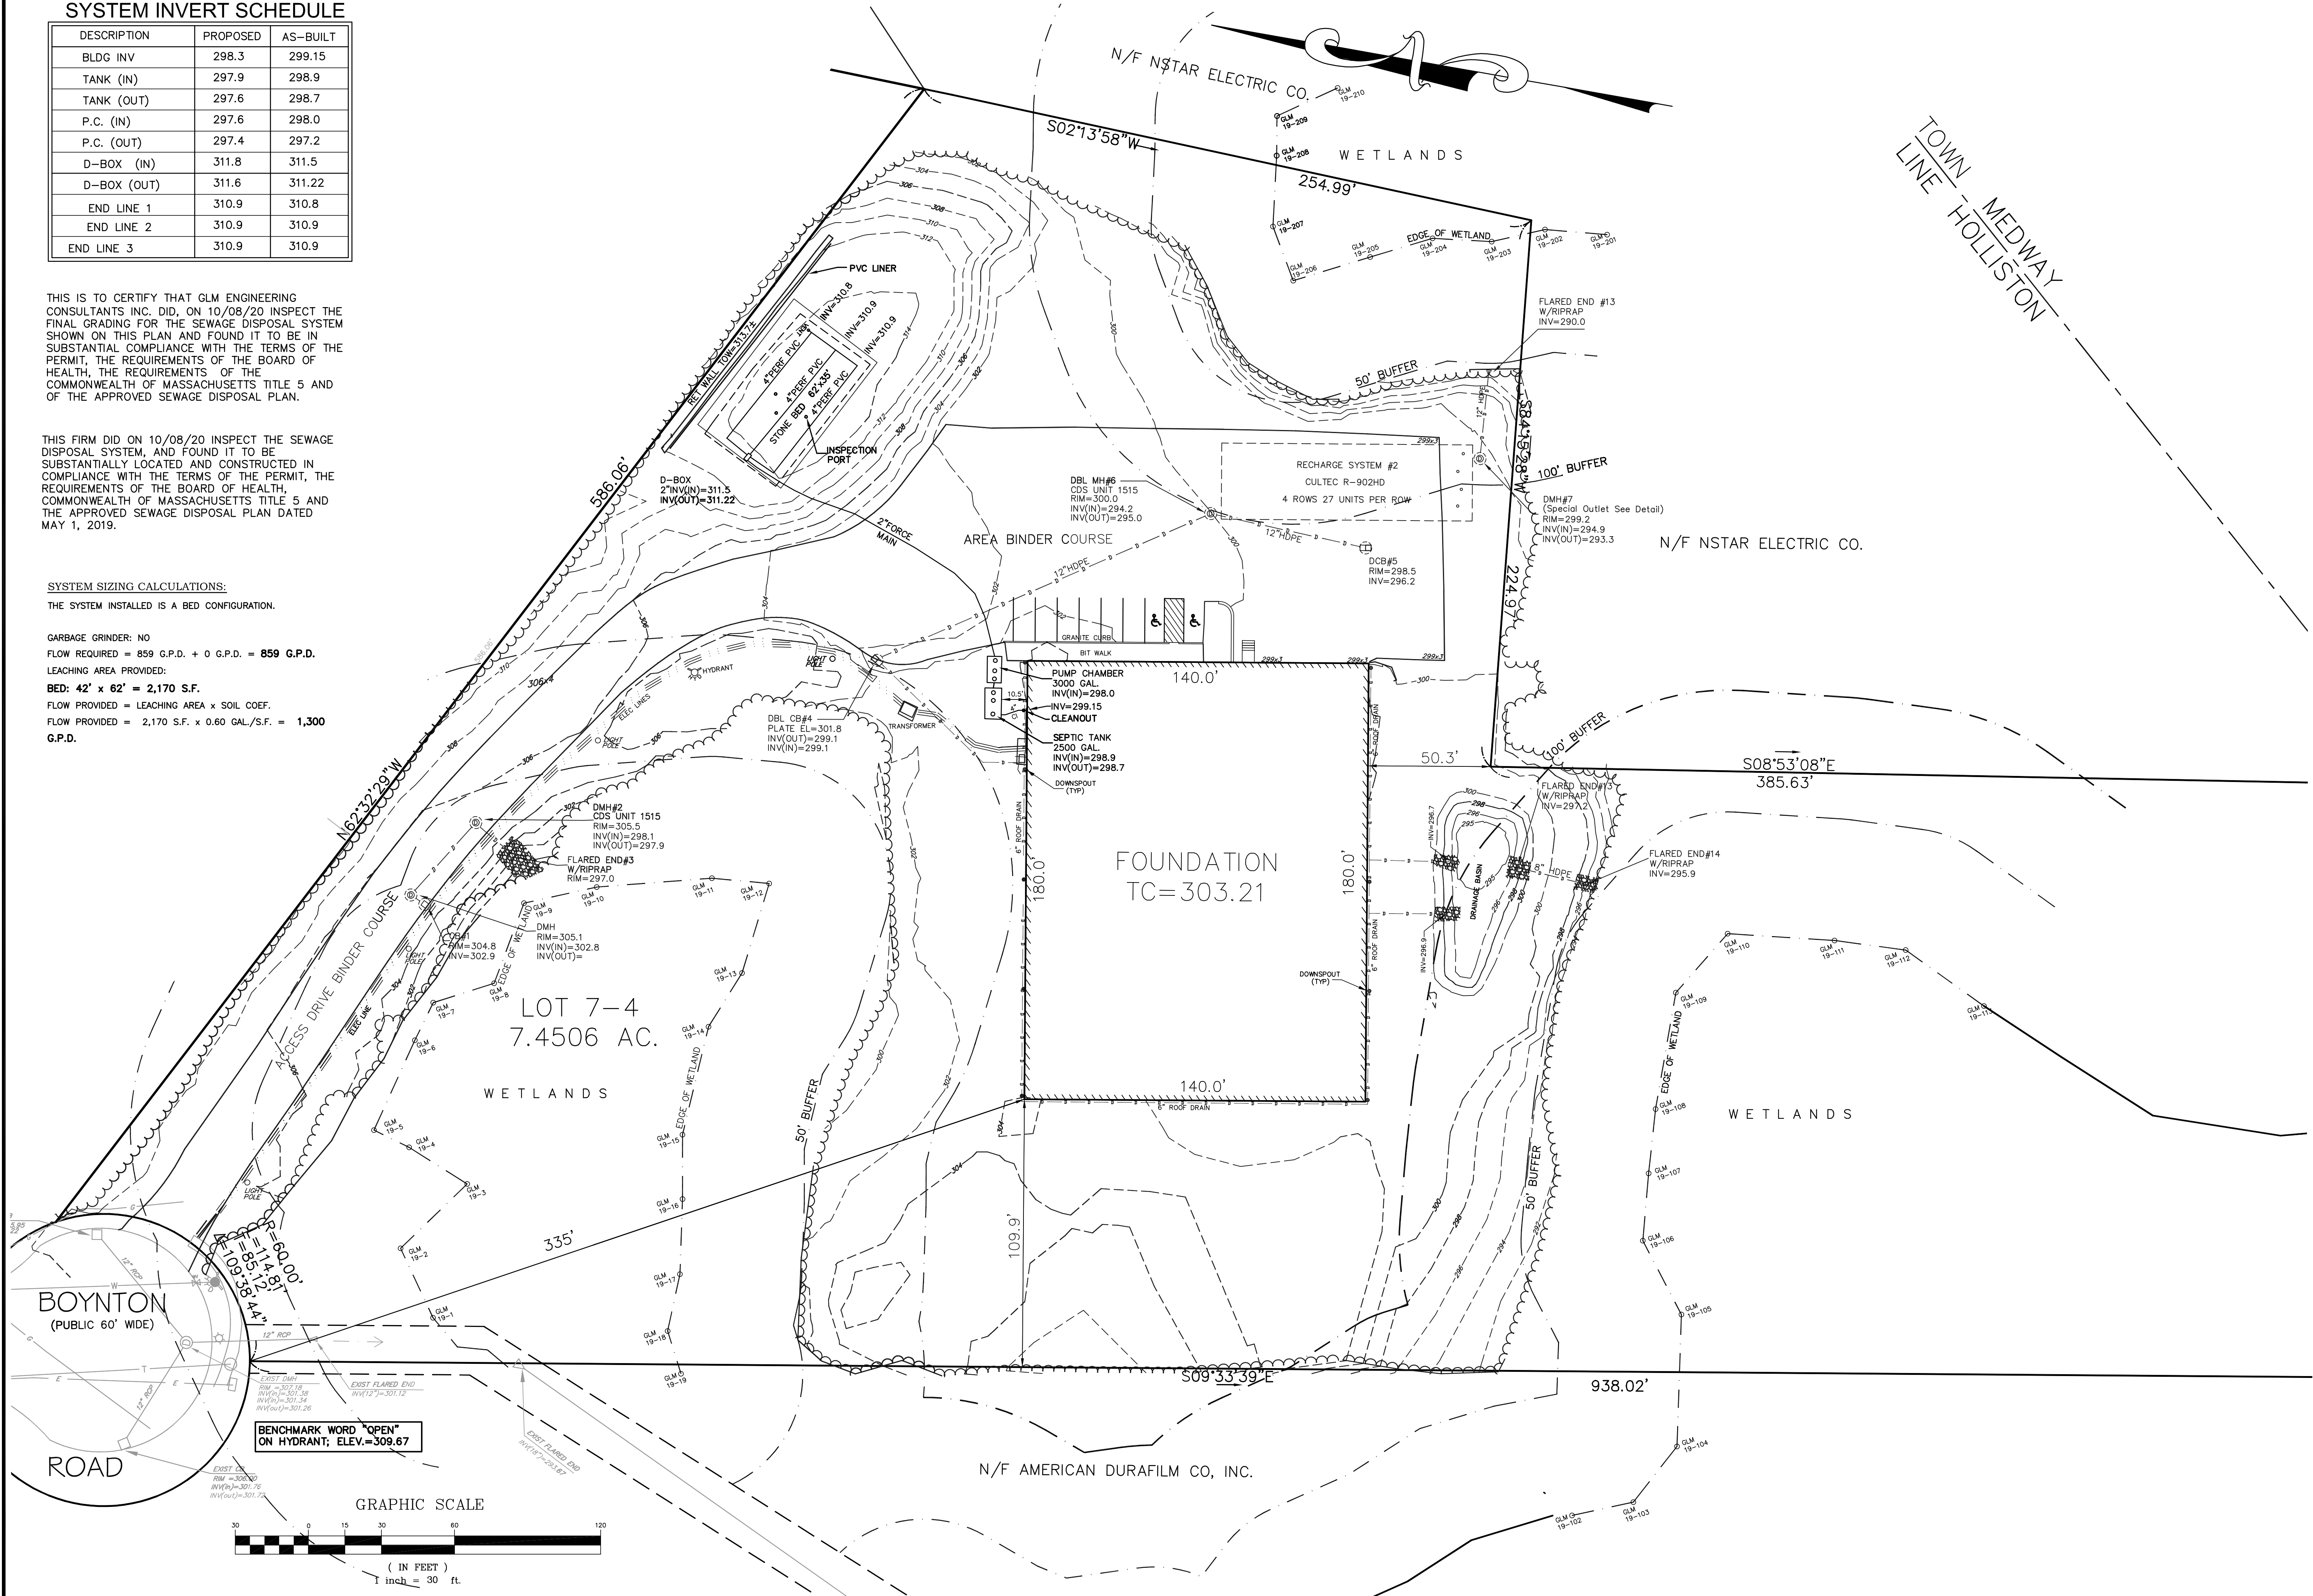

SITE AS-BUILT PLAN
"56 BOYNTON ROAD"
HOLLISTON, MASSACHUSETTS

OWNER & APPLICANT
HOPPING BROOK DEVELOPMENT LLC
330 HOPPING BROOK ROAD
HOLLISTON, MASSACHUSETTS 01746

GLM Engineering Consultants, Inc.
19 EXCHANGE STREET
HOLLISTON, MA 01746
P: 508-429-1100
F: 508-429-7160
www.GLMengineering.com

DRW.:
JOB No. 13,612
DATE: Oct. 14, 2020
SCALE: 1"=30'
SHEET: 1 of 1
PLAN #: 27,312-A