

- LEGEND
- 100' ELEVATION CONTOUR
- 100.5' SPOT ELEVATION
- VERTICAL GRANITE CURB (UNLESS OTHERWISE NOTED AS SLOPED GRANITE CURB)
- UTILITY MANHOLE
- DRAIN LINE
- DRAIN MANHOLE
- DRAIN CATCH BASIN
- DOUBLE-GRATE CATCH BASIN
- AREA DRAIN
- DRAIN OUTFALL
- WATER LINE
- WATER HYDRANT
- WATER GATE/VALVE
- WATER SHUT-OFF
- GAS LINE
- GAS GATE
- UNDERGROUND ELECTRIC
- UTILITY POLE
- ELECTRIC BOX
- ELECTRIC HANDHOLE
- TELEPHONE BOX
- CABLE TV BOX
- GUARD RAIL
- TREE LINE
- DECIDUOUS TREE
- CONIFER TREE
- STONE WALL
- FENCE
- SIGN
- LIGHT POST BASE
- MAIL BOX
- BOUND

- ABBREVIATIONS
- BIT BITUMINOUS
- (B) BOTTOM (ELEVATION)
- CONC CONCRETE
- CPP CORRUGATED PLASTIC PIPE
- EL ELEVATION
- EOP EDGE OF PAVEMENT
- FOD FULL OF DEBRIS
- FWW FULL OF WATER
- HDPE HIGH-DENSITY POLYETHYLENE
- II STRUCTURE INVERT IN ELEVATION
- Io STRUCTURE INVERT OUT ELEVATION
- MSRY MASONRY
- MTL METAL
- ND NOT DETERMINED (ELEVATION)
- N/F NOW OR FORMERLY
- NVP NO VISIBLE PIPES
- PVC POLYVINYL CHLORIDE
- R STRUCTURE RIM ELEVATION
- ROP REINFORCED CONCRETE PIPE
- RET WALL RETAINING WALL
- SOC SLOPED GRANITE CURB
- (T) TOP (ELEVATION)
- TOC TOP OF CONCRETE (ELEVATION)
- TOO TOP OF DEBRIS (ELEVATION)
- TOW TOP OF WATER (ELEVATION)
- VGC VERTICAL GRANITE CURB



NOTE: CONSTRUCTION ON THIS PROJECT IS SUBJECT TO ANY EASEMENTS, RIGHTS-OF-WAY, RESTRICTIONS, RESERVATIONS OR OTHER LIMITATIONS WHICH MAY BE REVEALED BY AN EXAMINATION OF THE TITLE.

DIG SAFE NOTE:

UTILITIES ARE PLOTTED FROM FIELD LOCATION AND ANY RECORD INFORMATION AVAILABLE, AND SHOULD BE CONSIDERED APPROXIMATE. OTHER UTILITIES MAY EXIST WHICH ARE NOT EVIDENT OR FOR WHICH RECORD INFORMATION WAS NOT AVAILABLE. CONTRACTORS IN ACCORDANCE WITH MASS.G.L. CHAPTER 82 SECTION 40 AS AMENDED MUST CONTACT ALL UTILITY COMPANIES BEFORE EXCAVATING AND DRILLING. CALL "DIG-SAFE" AT 811.

EXISTING LINES OTHER THAN THOSE INDICATED ON THESE DRAWINGS MAY BE ON THE SITE. THE CONTRACTOR IS WARNED TO PROCEED WITH CAUTION WITH ALL WORK, ESPECIALLY EXCAVATION WORK, AND TO MAKE ALL POSSIBLE INVESTIGATIONS AS TO POSSIBLE UNMARKED UTILITY LINES.

NOTES

1. SEE PLAN NO. 1006 OF 1999 AND PLAN NO. 100 OF 2000 RECORDED AT THE MIDDLESEX SOUTH DISTRICT REGISTRY OF DEEDS.


OWNER:
HOLLISTON RESIDENTIAL REALTY, LLC
120 QUARRY DRIVE
MILFORD, MA 01757

"THE HIGHLANDS AT HOLLISTON"
INDIAN CIRCLE
MAYFLOWER LANDING
MOHAWK PATH

AS-BUILT PLAN AND PROFILE
OF LAND
IN
Holliston, Massachusetts
SCALE: 250 FEET TO AN INCH
DATE: JANUARY 6, 2017

NO.	DATE	DESCRIPTION	BY
1	06-15-17	03-17-17 PLANNER COMMENTS	FJO
2	09-24-18	REVIEW COMMENTS	FJO
3	08-20-19	REVIEW COMMENTS	FJO
4	01-24-20	EASEMENTS	FJO
5	10-15-20	PLANNER COMMENTS	FJO
6	01-21-21	MAYFLOWER WATER UTILITY PROPOSED UTILITY EASEMENT AT MAYFLOWER LANDING	FJO

Guerriere & Halnon, Inc.
Engineering & Land Surveying
333 WEST STREET, MILFORD, MASS. 01757
(508) 473-6630 FAX: (508) 473-8243
www.gandhengineering.com



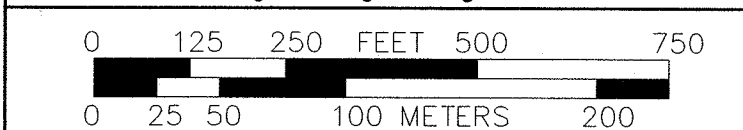


SHEET 1 OF 13
SITE INDEX SHEET

G-1816-7

G-1816-7

G:\CD\Milford\G-1816-7\DWG\G-1816-7 ASSD.dwg

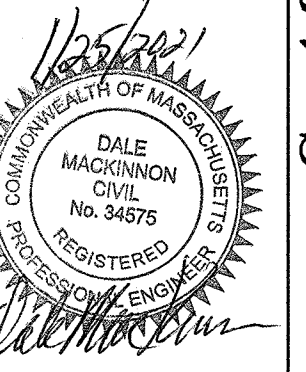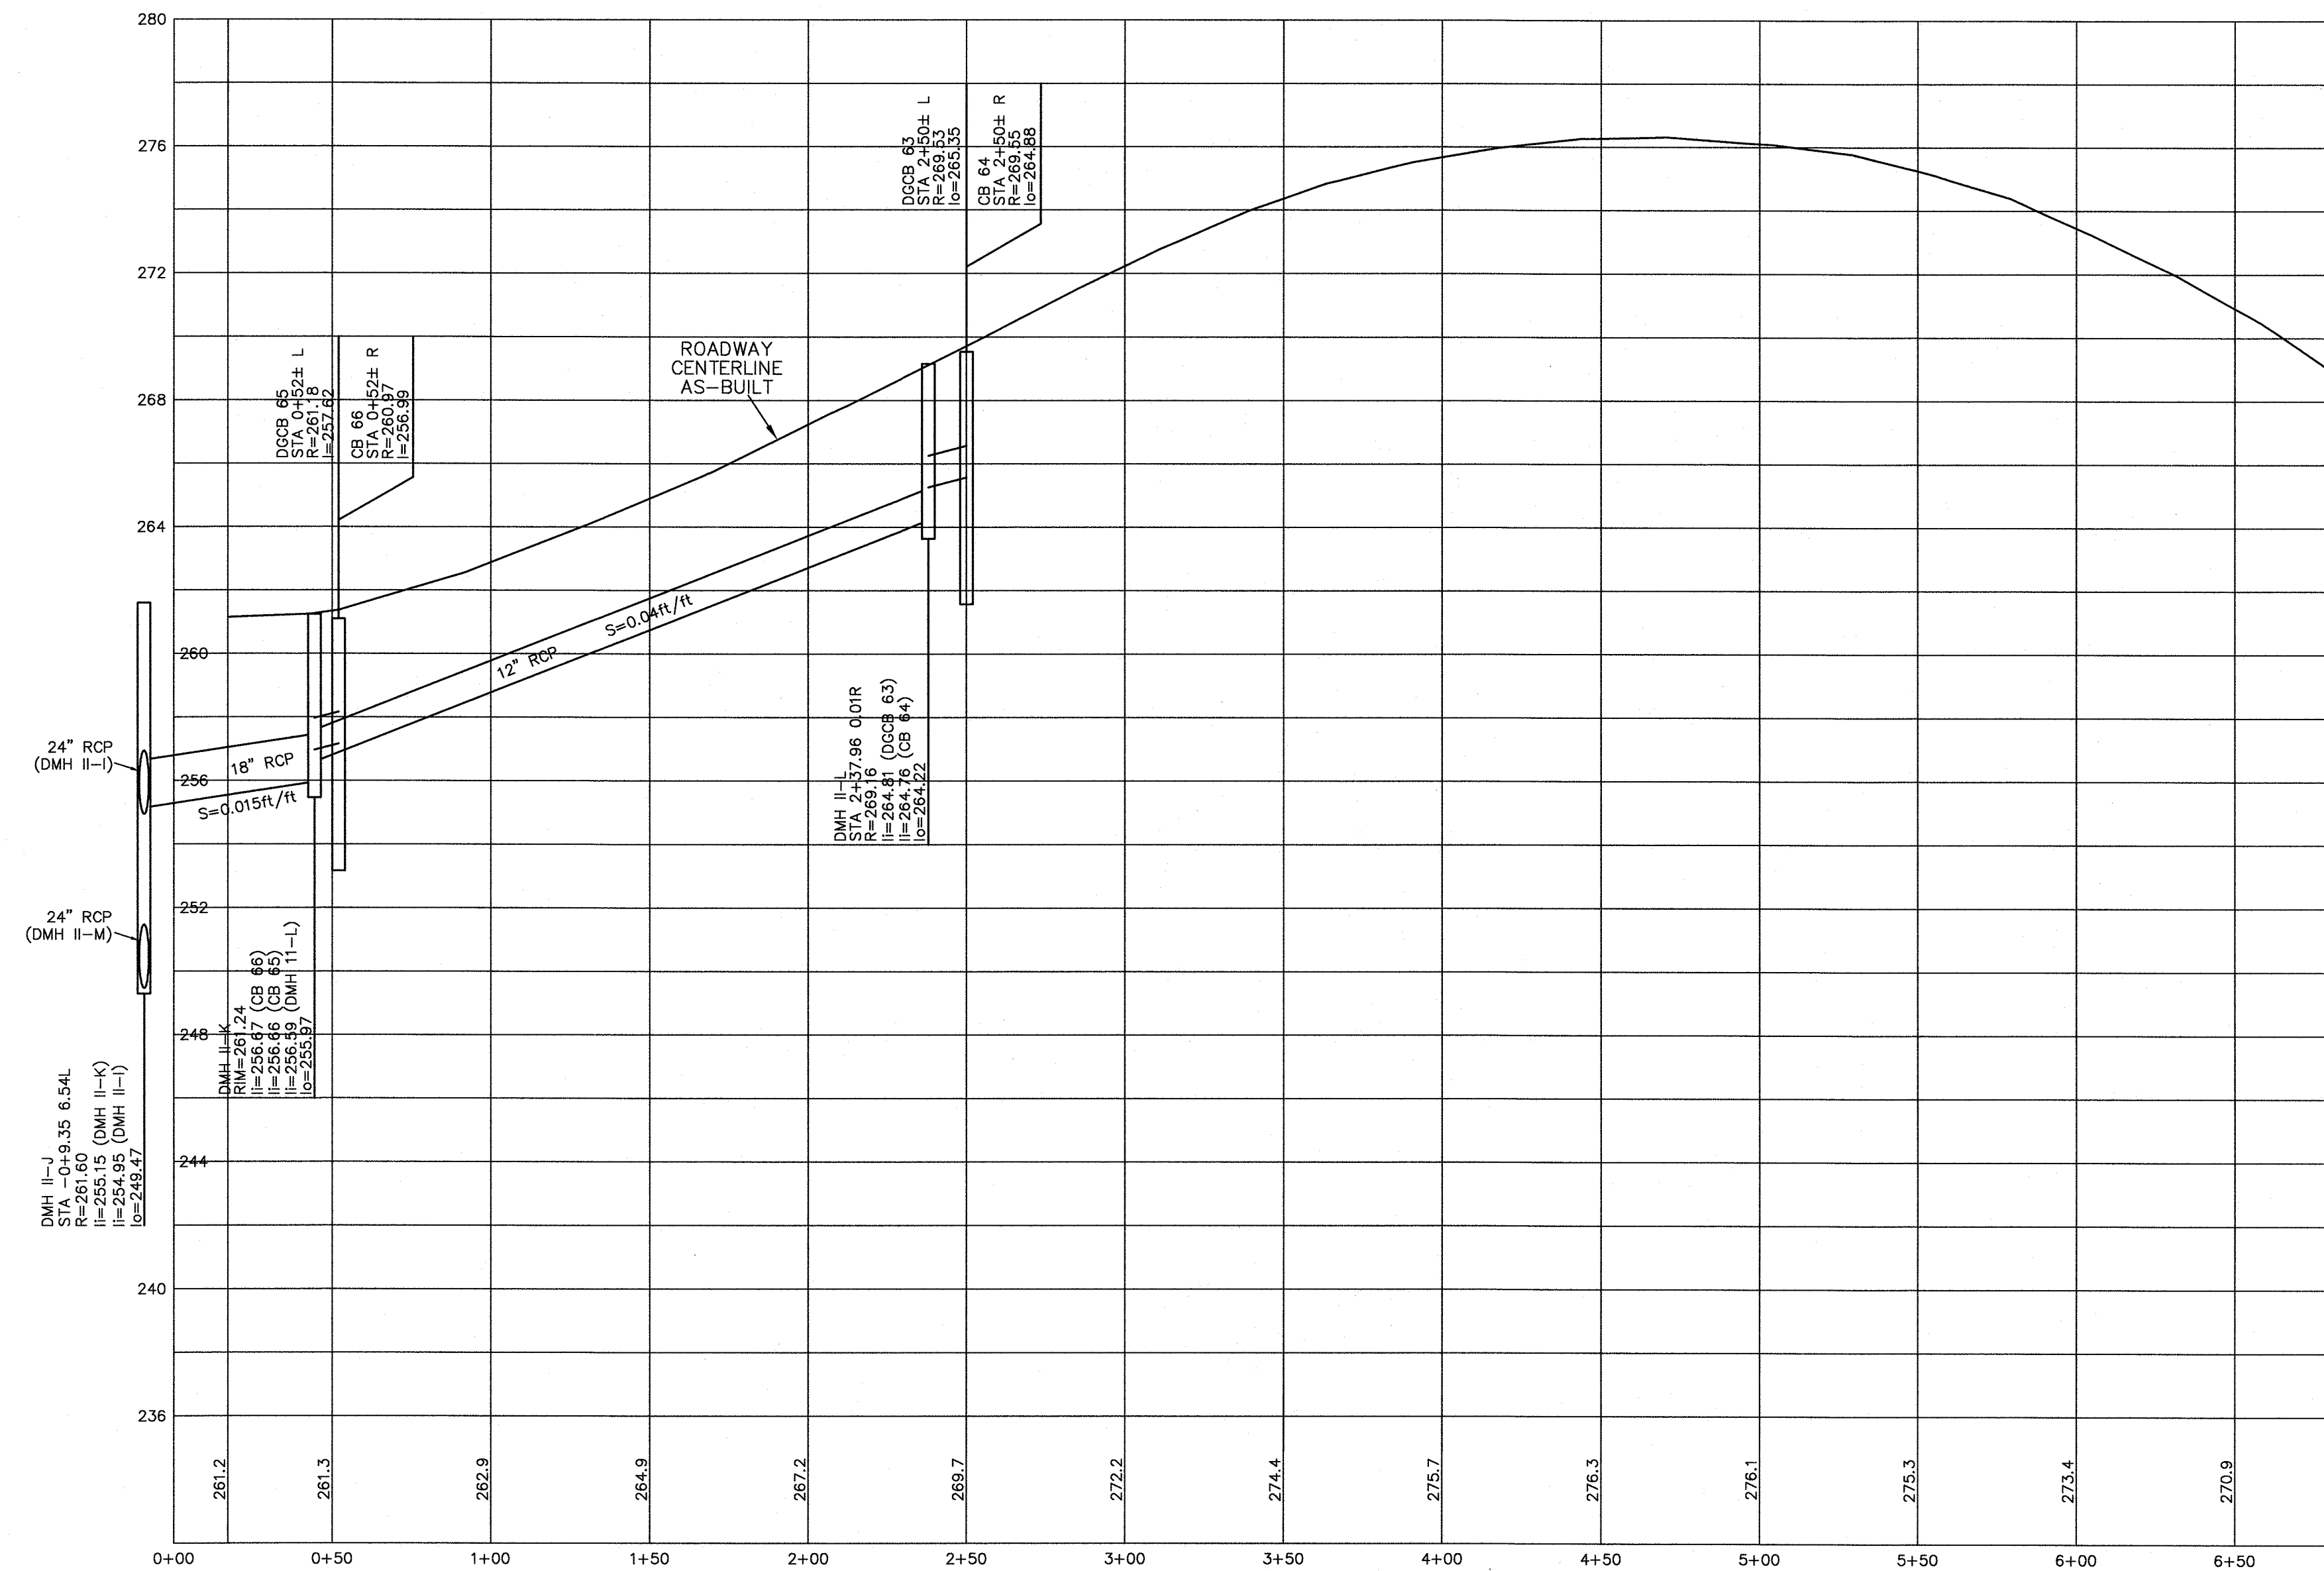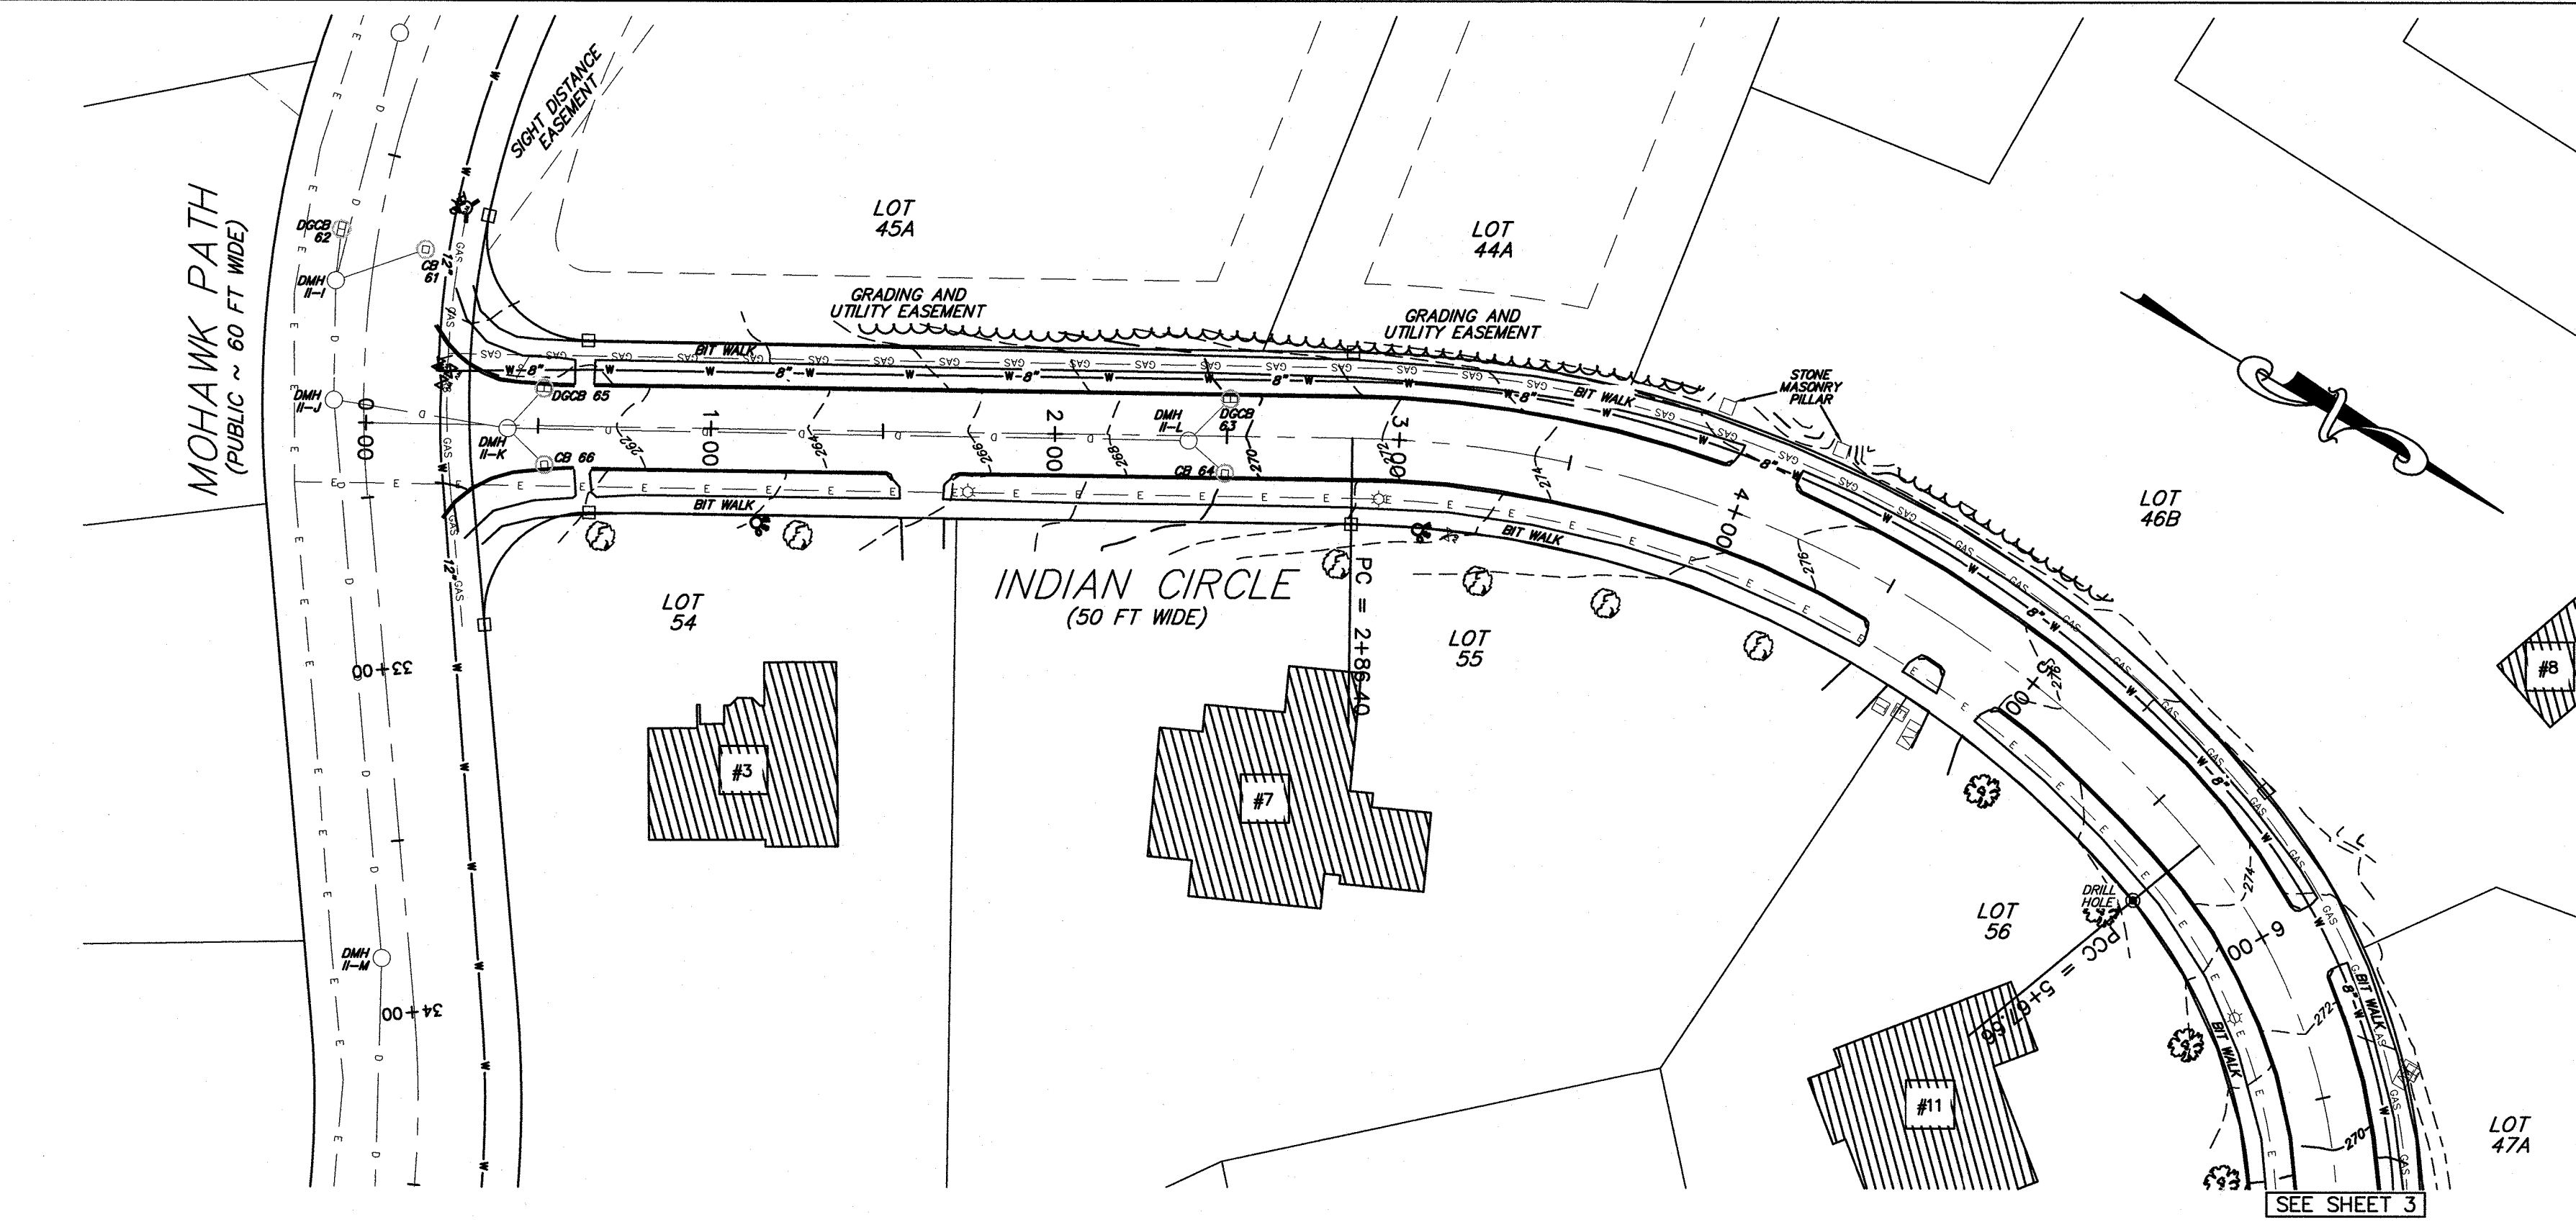

NOTE: CONSTRUCTION ON THIS PROJECT IS SUBJECT TO ANY EASEMENTS, RIGHTS-OF-WAY, RESTRICTIONS, RESERVATIONS OR OTHER LIMITATIONS WHICH MAY BE REVEALED BY AN EXAMINATION OF THE TITLE.



DIG SAFE NOTE:
UTILITIES ARE PLOTTED FROM FIELD LOCATION AND ANY RECORD INFORMATION AVAILABLE, AND SHOULD BE CONSIDERED APPROXIMATE. OTHER UTILITIES MAY EXIST WHICH ARE NOT EVIDENT OR FOR WHICH RECORD INFORMATION WAS NOT AVAILABLE. CONTRACTORS (IN ACCORDANCE WITH MASS.G.L. CHAPTER 82, SECTION 40 AS AMENDED) MUST CONTACT ALL UTILITY COMPANIES BEFORE EXCAVATING AND DRILLING.
CALL "DIG-SAFE" AT 811.
EXISTING LINES OTHER THAN THOSE INDICATED ON THESE DRAWINGS MAY BE ON THE SITE. THE CONTRACTOR IS WARNED TO PROCEED WITH CAUTION WITH ALL WORK, ESPECIALLY EXCAVATION WORK, AND TO MAKE ALL POSSIBLE INVESTIGATIONS AS TO POSSIBLE UNMARKED UTILITY LINES.

NOTES

1. SEE PLAN NO. 1006 OF 1999 AND PLAN NO. 100 OF 2000 RECORDED AT THE MIDDLESEX SOUTH DISTRICT REGISTRY OF DEEDS.

OWNER:
HOLLISTON RESIDENTIAL REALTY, LLC
120 QUARRY DRIVE
MILFORD, MA 01757

"THE HIGHLANDS AT HOLLISTON"
INDIAN CIRCLE
MAYFLOWER LANDING
MOHAWK PATH


AS-BUILT PLAN AND PROFILE
OF LAND
IN

Holliston, Massachusetts

SCALE: 40 FEET TO AN INCH HORIZONTAL
4 FEET TO AN INCH VERTICAL
DATE: JANUARY 6, 2017

REVISIONS			
NO.	DATE	DESCRIPTION	BY
1	06-15-17	03-17-17 PLANNER COMMENTS	FJO
2	09-24-18	REVIEW COMMENTS	FJO
3	08-20-19	REVIEW COMMENTS	FJO
4	01-24-20	EASEMENTS	FJO
5	10-15-20	PLANNER COMMENTS	FJO
6	01-21-21	MAYFLOWER WATER UTILITY PROPOSED UTILITY EASEMENT AT MAYFLOWER HOA EASEMENTS	FJO

Guerriere & Halnon, Inc.
Engineering & Land Surveying
333 WEST STREET, MILFORD, MASS. 01757
(508) 473-6630 FAX: (508) 473-8243
www.gandhengineering.com

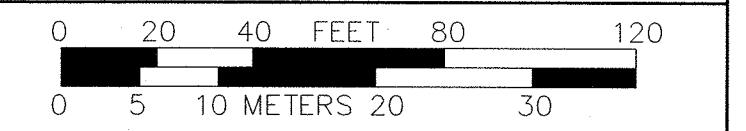

SHEET 2 OF 13
INDIAN CIRCLE
STA 0+00 TO STA 6+50

G-1816-7



UTILITIES ARE PLOTTED FROM FIELD LOCATION AND ANY RECORD INFORMATION AVAILABLE, AND SHOULD BE CONSIDERED APPROXIMATE. OTHER UTILITIES MAY EXIST WHICH ARE NOT EVIDENT OR FOR WHICH RECORD INFORMATION WAS NOT AVAILABLE. CONTRACTORS (IN ACCORDANCE WITH MASS.G.L. CHAPTER 82 SECTION 40 AS AMENDED) MUST CONTACT ALL UTILITY COMPANIES BEFORE EXCAVATING AND DRILLING.
CALL "DIG-SAFE" AT 811.

1. SEE PLAN NO. 1006 OF 1999
AND PLAN NO. 100 OF 2000
RECORDED AT THE MIDDLESEX SOUTH DISTRICT
REGISTRY OF DEEDS.

SCALE: 40 FEET TO AN INCH HORIZONTAL
4 FEET TO AN INCH VERTICAL
DATE: JANUARY 6, 2017



REVISIONS			
NO.	DATE	DESCRIPTION	BY
1	06-15-17	03-17-17 PLANNER COMMENTS	FJC
2	09-24-18	REVIEW COMMENTS	FJC
3	08-20-19	REVIEW COMMENTS	FJC
4	01-24-20	EASEMENTS	FJC
5	10-15-20	PLANNER COMMENTS	FJC
6	01-21-21	MAYFLOWER WATER UTILITY PROPOSED UTILITY EASEMENT AT MAYFLOWER PVA EASEMENTS	FJC




Engineering & Land Surveying
333 WEST STREET, MILFORD, MASS. 01757
(508) 473-6630 FAX: (508) 473-8242
www.gandhengineering.com



F.10

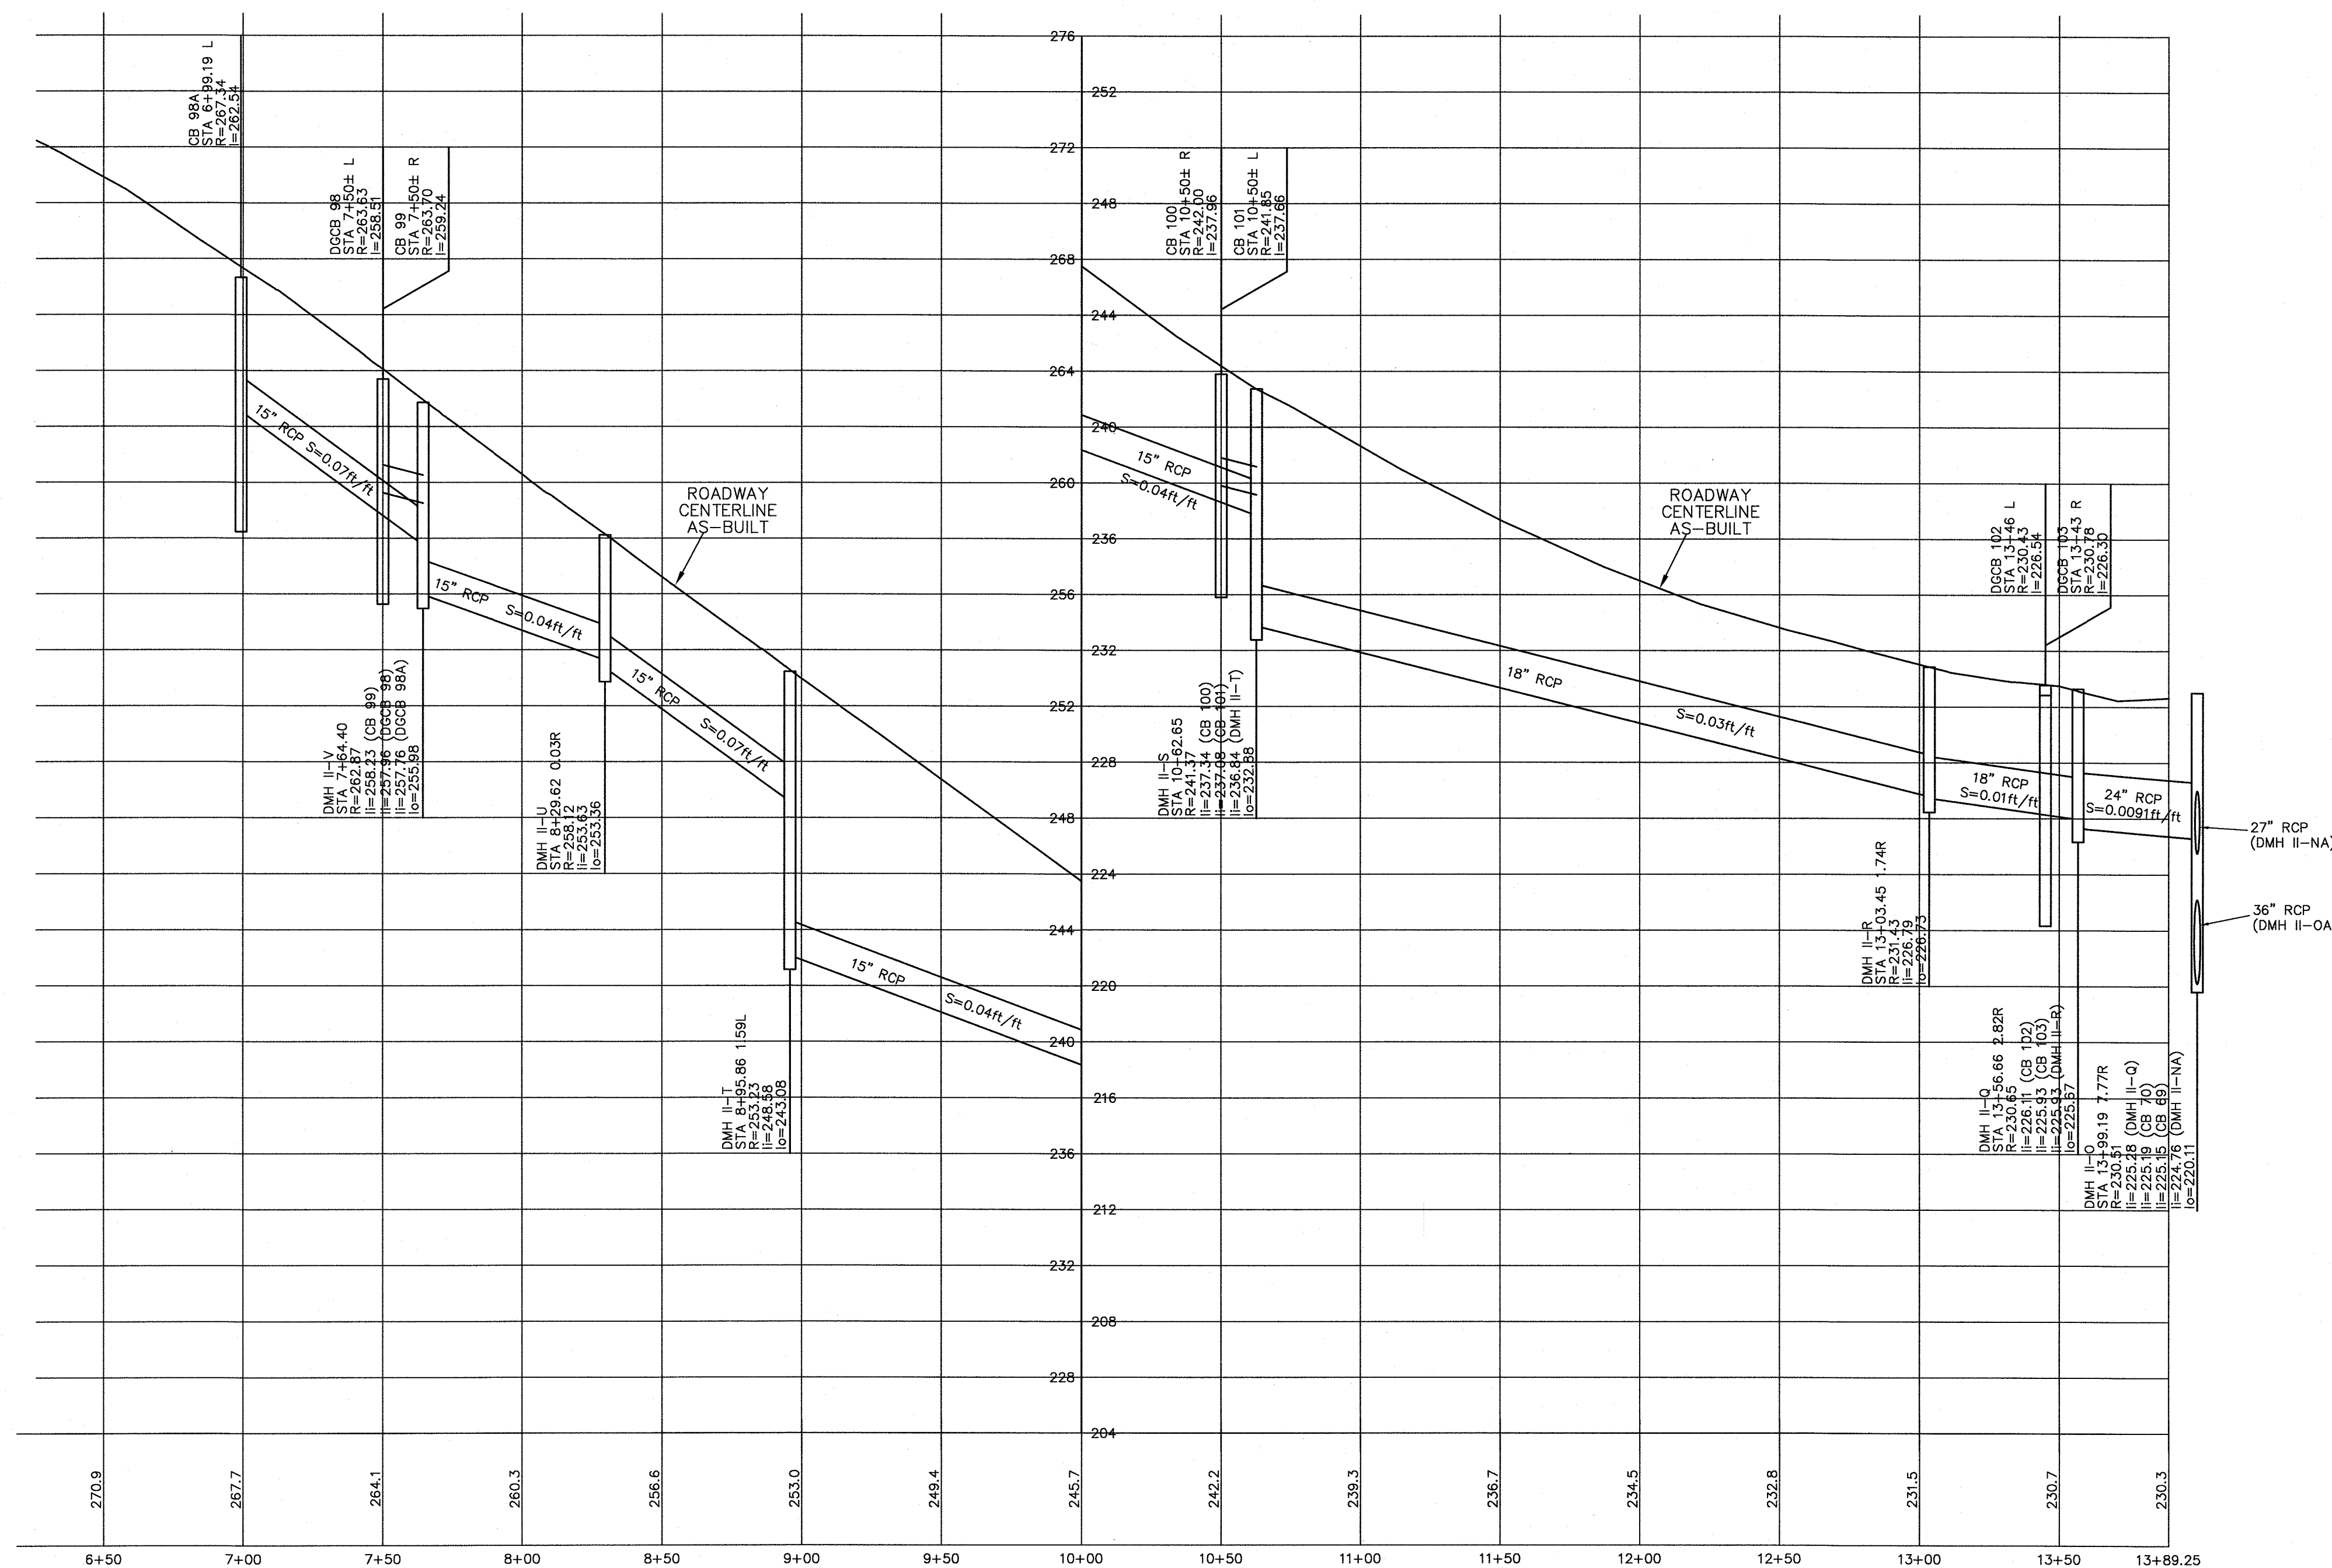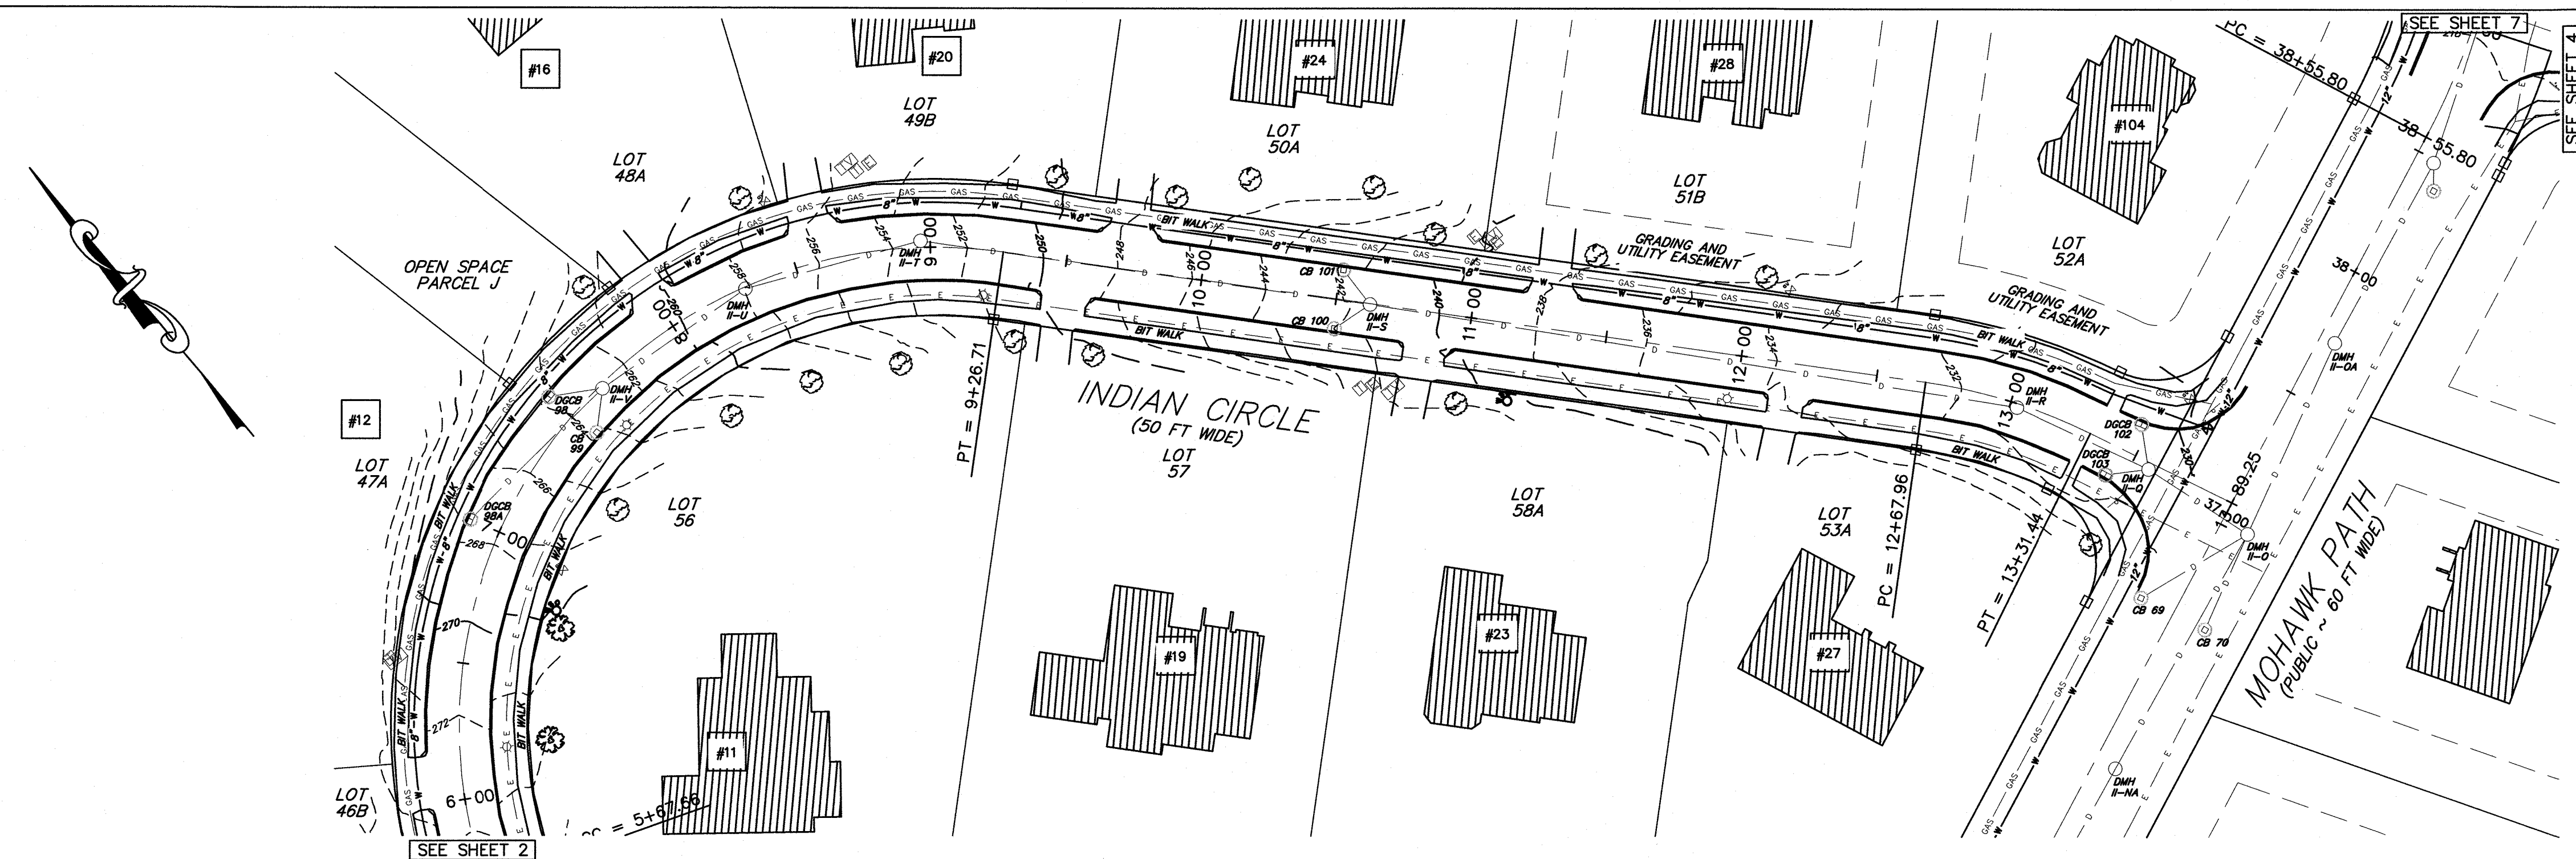

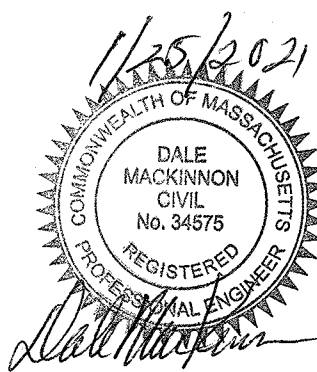

NOTE: CONSTRUCTION ON THIS PROJECT IS SUBJECT TO ANY EASEMENTS, RIGHTS-OF-WAY, RESTRICTIONS, RESERVATIONS OR OTHER LIMITATIONS WHICH MAY BE REVEALED BY AN EXAMINATION OF THE TITLE.

**DIG SAFE NOTE:**

UTILITIES ARE PLOTTED FROM FIELD LOCATION AND ANY RECORD INFORMATION AVAILABLE, AND SHOULD BE CONSIDERED APPROXIMATE. OTHER UTILITIES MAY EXIST WHICH ARE NOT EVIDENT OR FOR WHICH RECORD INFORMATION WAS NOT AVAILABLE. CONTRACTORS IN ACCORDANCE WITH MASS.G.L. CHAPTER 82, SECTION 40 AS AMENDED MUST CONTACT ALL UTILITY COMPANIES BEFORE EXCAVATING AND DRILLING. CALL "DIG-SAFE" AT 811.

EXISTING LINES OTHER THAN THOSE INDICATED ON THESE DRAWINGS MAY BE ON THE SITE. THE CONTRACTOR IS WARNED TO PROCEED WITH CAUTION WITH ALL WORK, ESPECIALLY EXCAVATION WORK, AND TO MAKE ALL POSSIBLE INVESTIGATIONS AS TO POSSIBLE UNMARKED UTILITY LINES.

NOTES

1. SEE PLAN NO. 1006 OF 1999 AND PLAN NO. 100 OF 2000 RECORDED AT THE MIDDLESEX SOUTH DISTRICT REGISTRY OF DEEDS.

OWNER:
HOLLISTON RESIDENTIAL REALTY, LLC
120 QUARRY DRIVE
MILFORD, MA 01757

"THE HIGHLANDS AT HOLLISTON"
INDIAN CIRCLE
MAYFLOWER LANDING
MOHAWK PATH

AS-BUILT PLAN AND PROFILE
OF LAND

Holliston, Massachusetts


SCALE: 40 FEET TO AN INCH HORIZONTAL
4 FEET TO AN INCH VERTICAL
DATE: JANUARY 6, 2017


REVISIONS			
NO.	DATE	DESCRIPTION	BY
1	06-15-17	03-17-17 PLANNER COMMENTS	FJO
2	09-24-18	REVIEW COMMENTS	FJO
3	08-20-19	REVIEW COMMENTS	FJO
4	01-24-20	EASEMENTS	FJO
5	10-15-20	PLANNER COMMENTS	FJO
6	01-21-21	MAYFLOWER WATER UTILITY PROPOSED UTILITY EASEMENT AT MAYFLOWER	FJO


Guerriere & Halnon, Inc.
Engineering & Land Surveying
333 WEST STREET, MILFORD, MASS. 01757
(508) 473-6630 FAX: (508) 473-8243
www.gondhengineering.com



SHEET 4 OF 13
MAYFLOWER LANDING
STA 0+00 TO STA 10+50

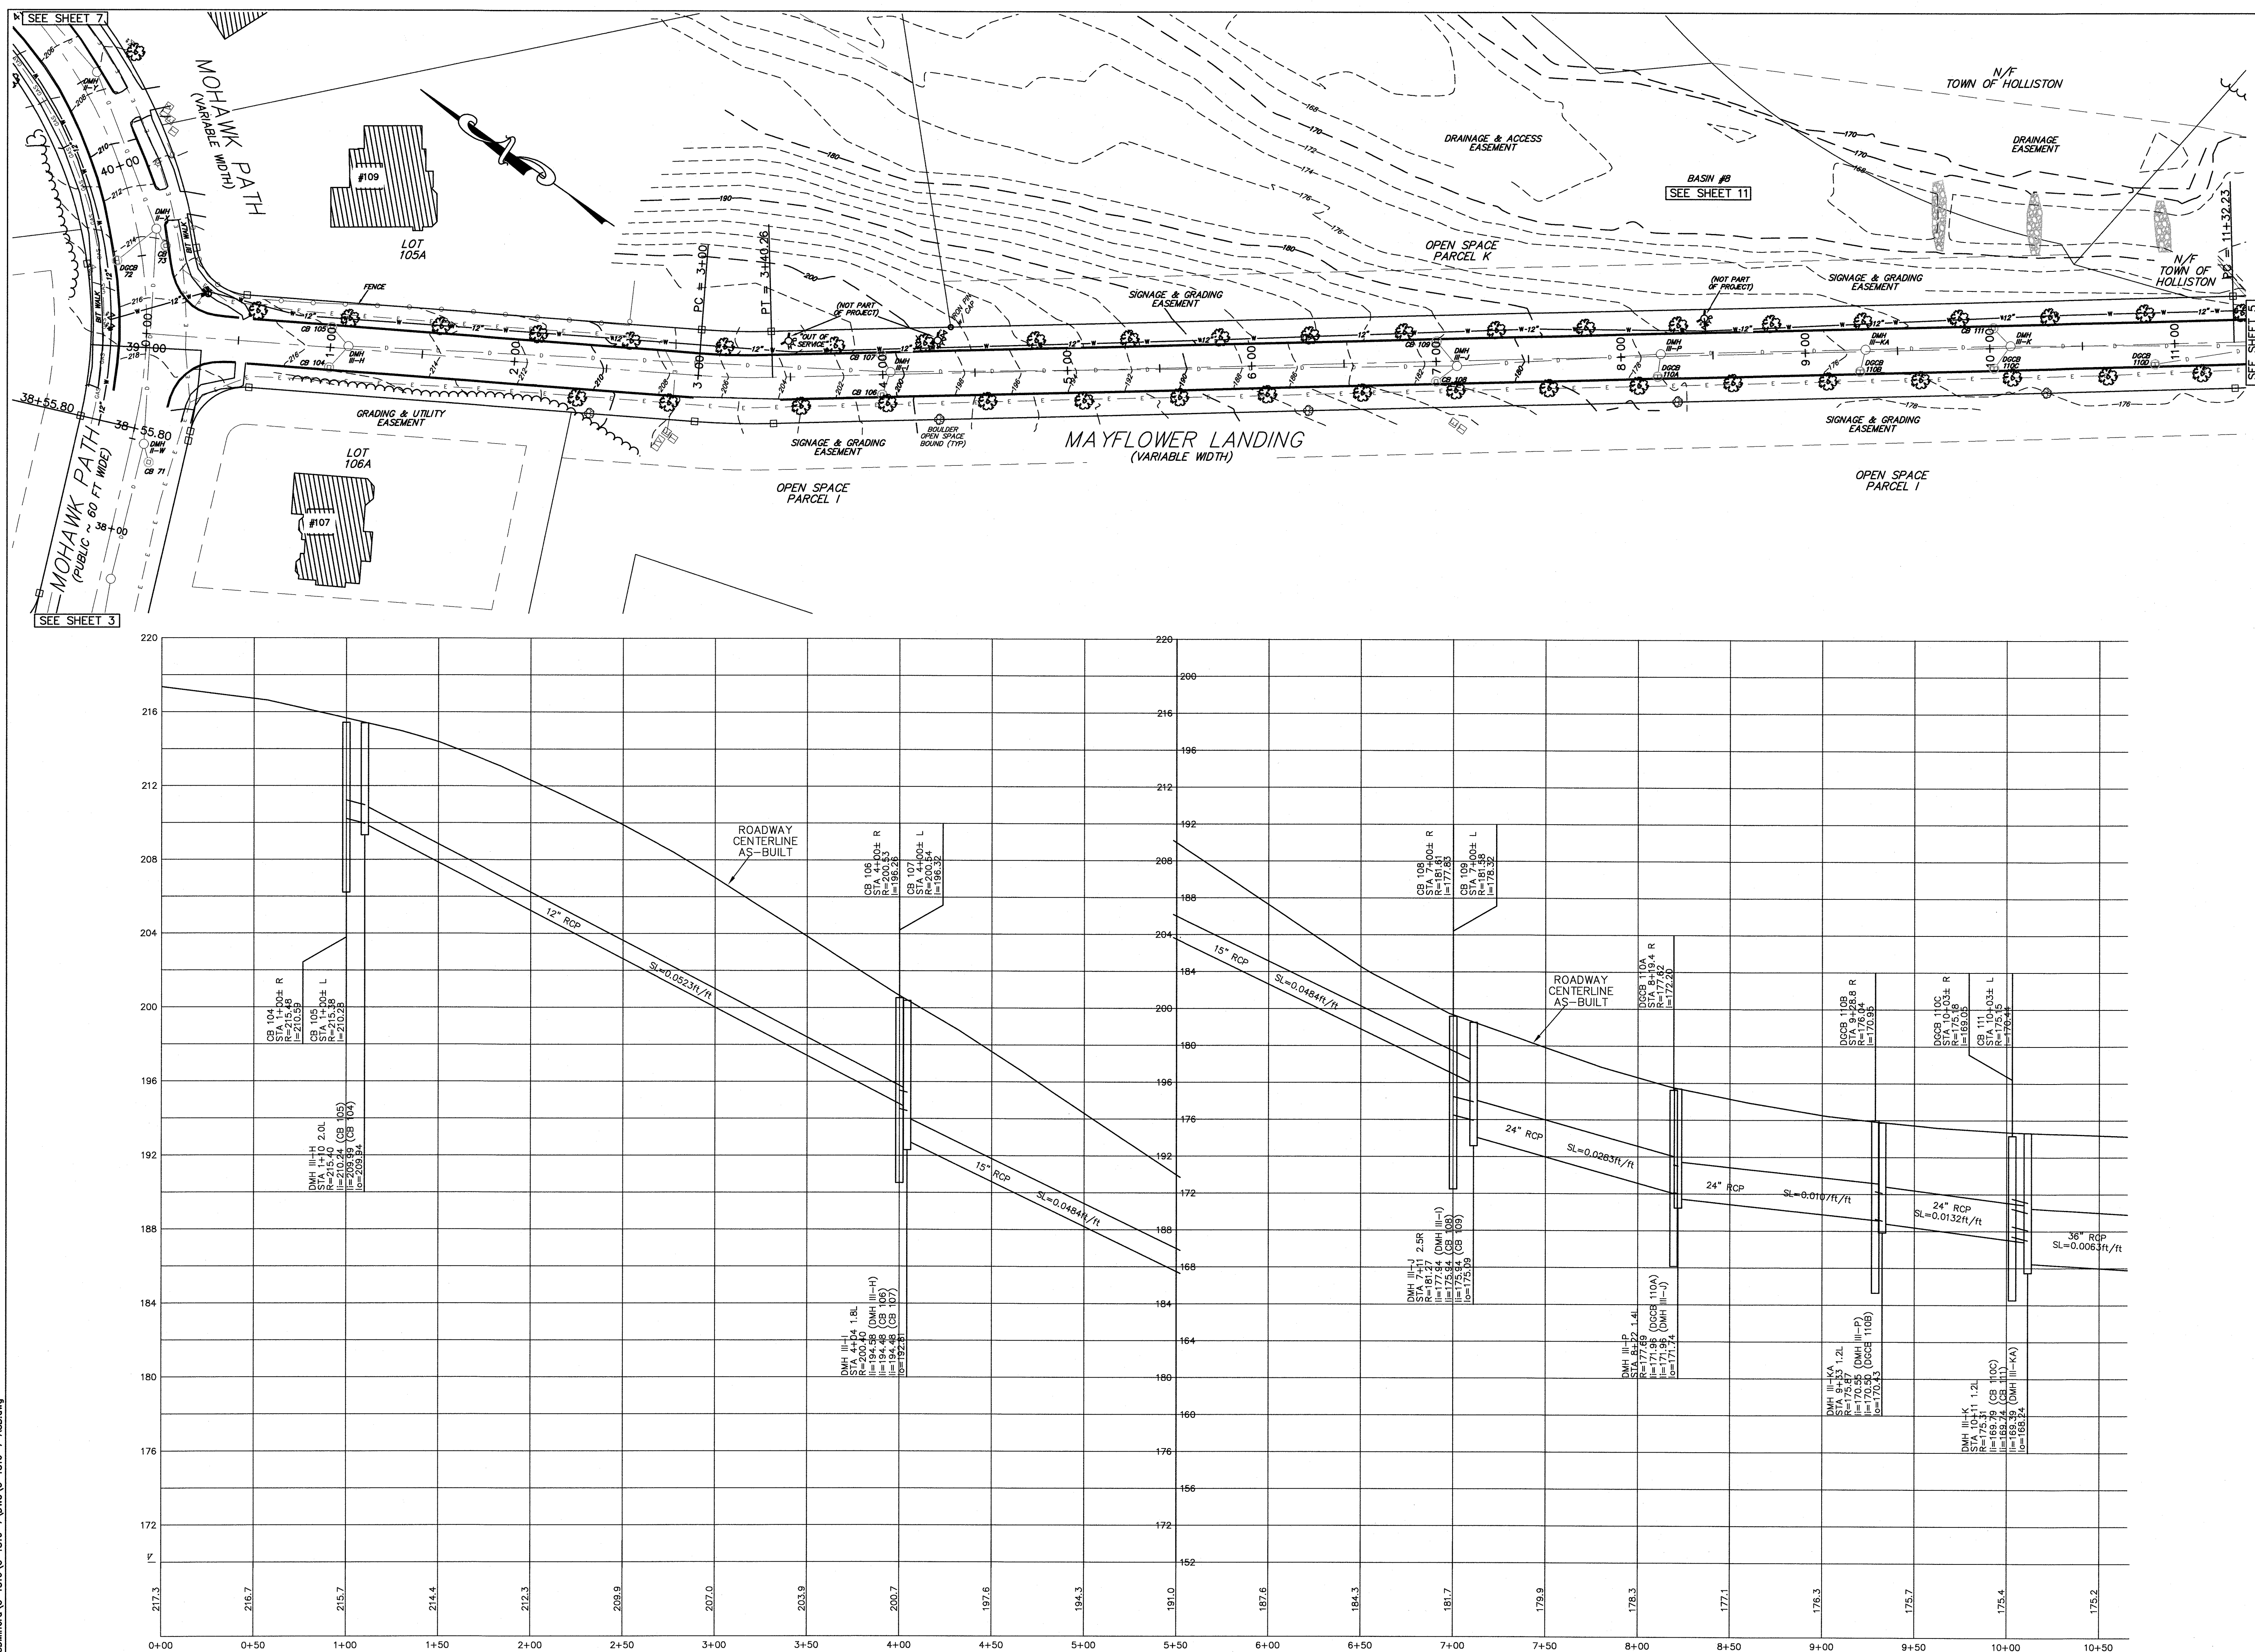

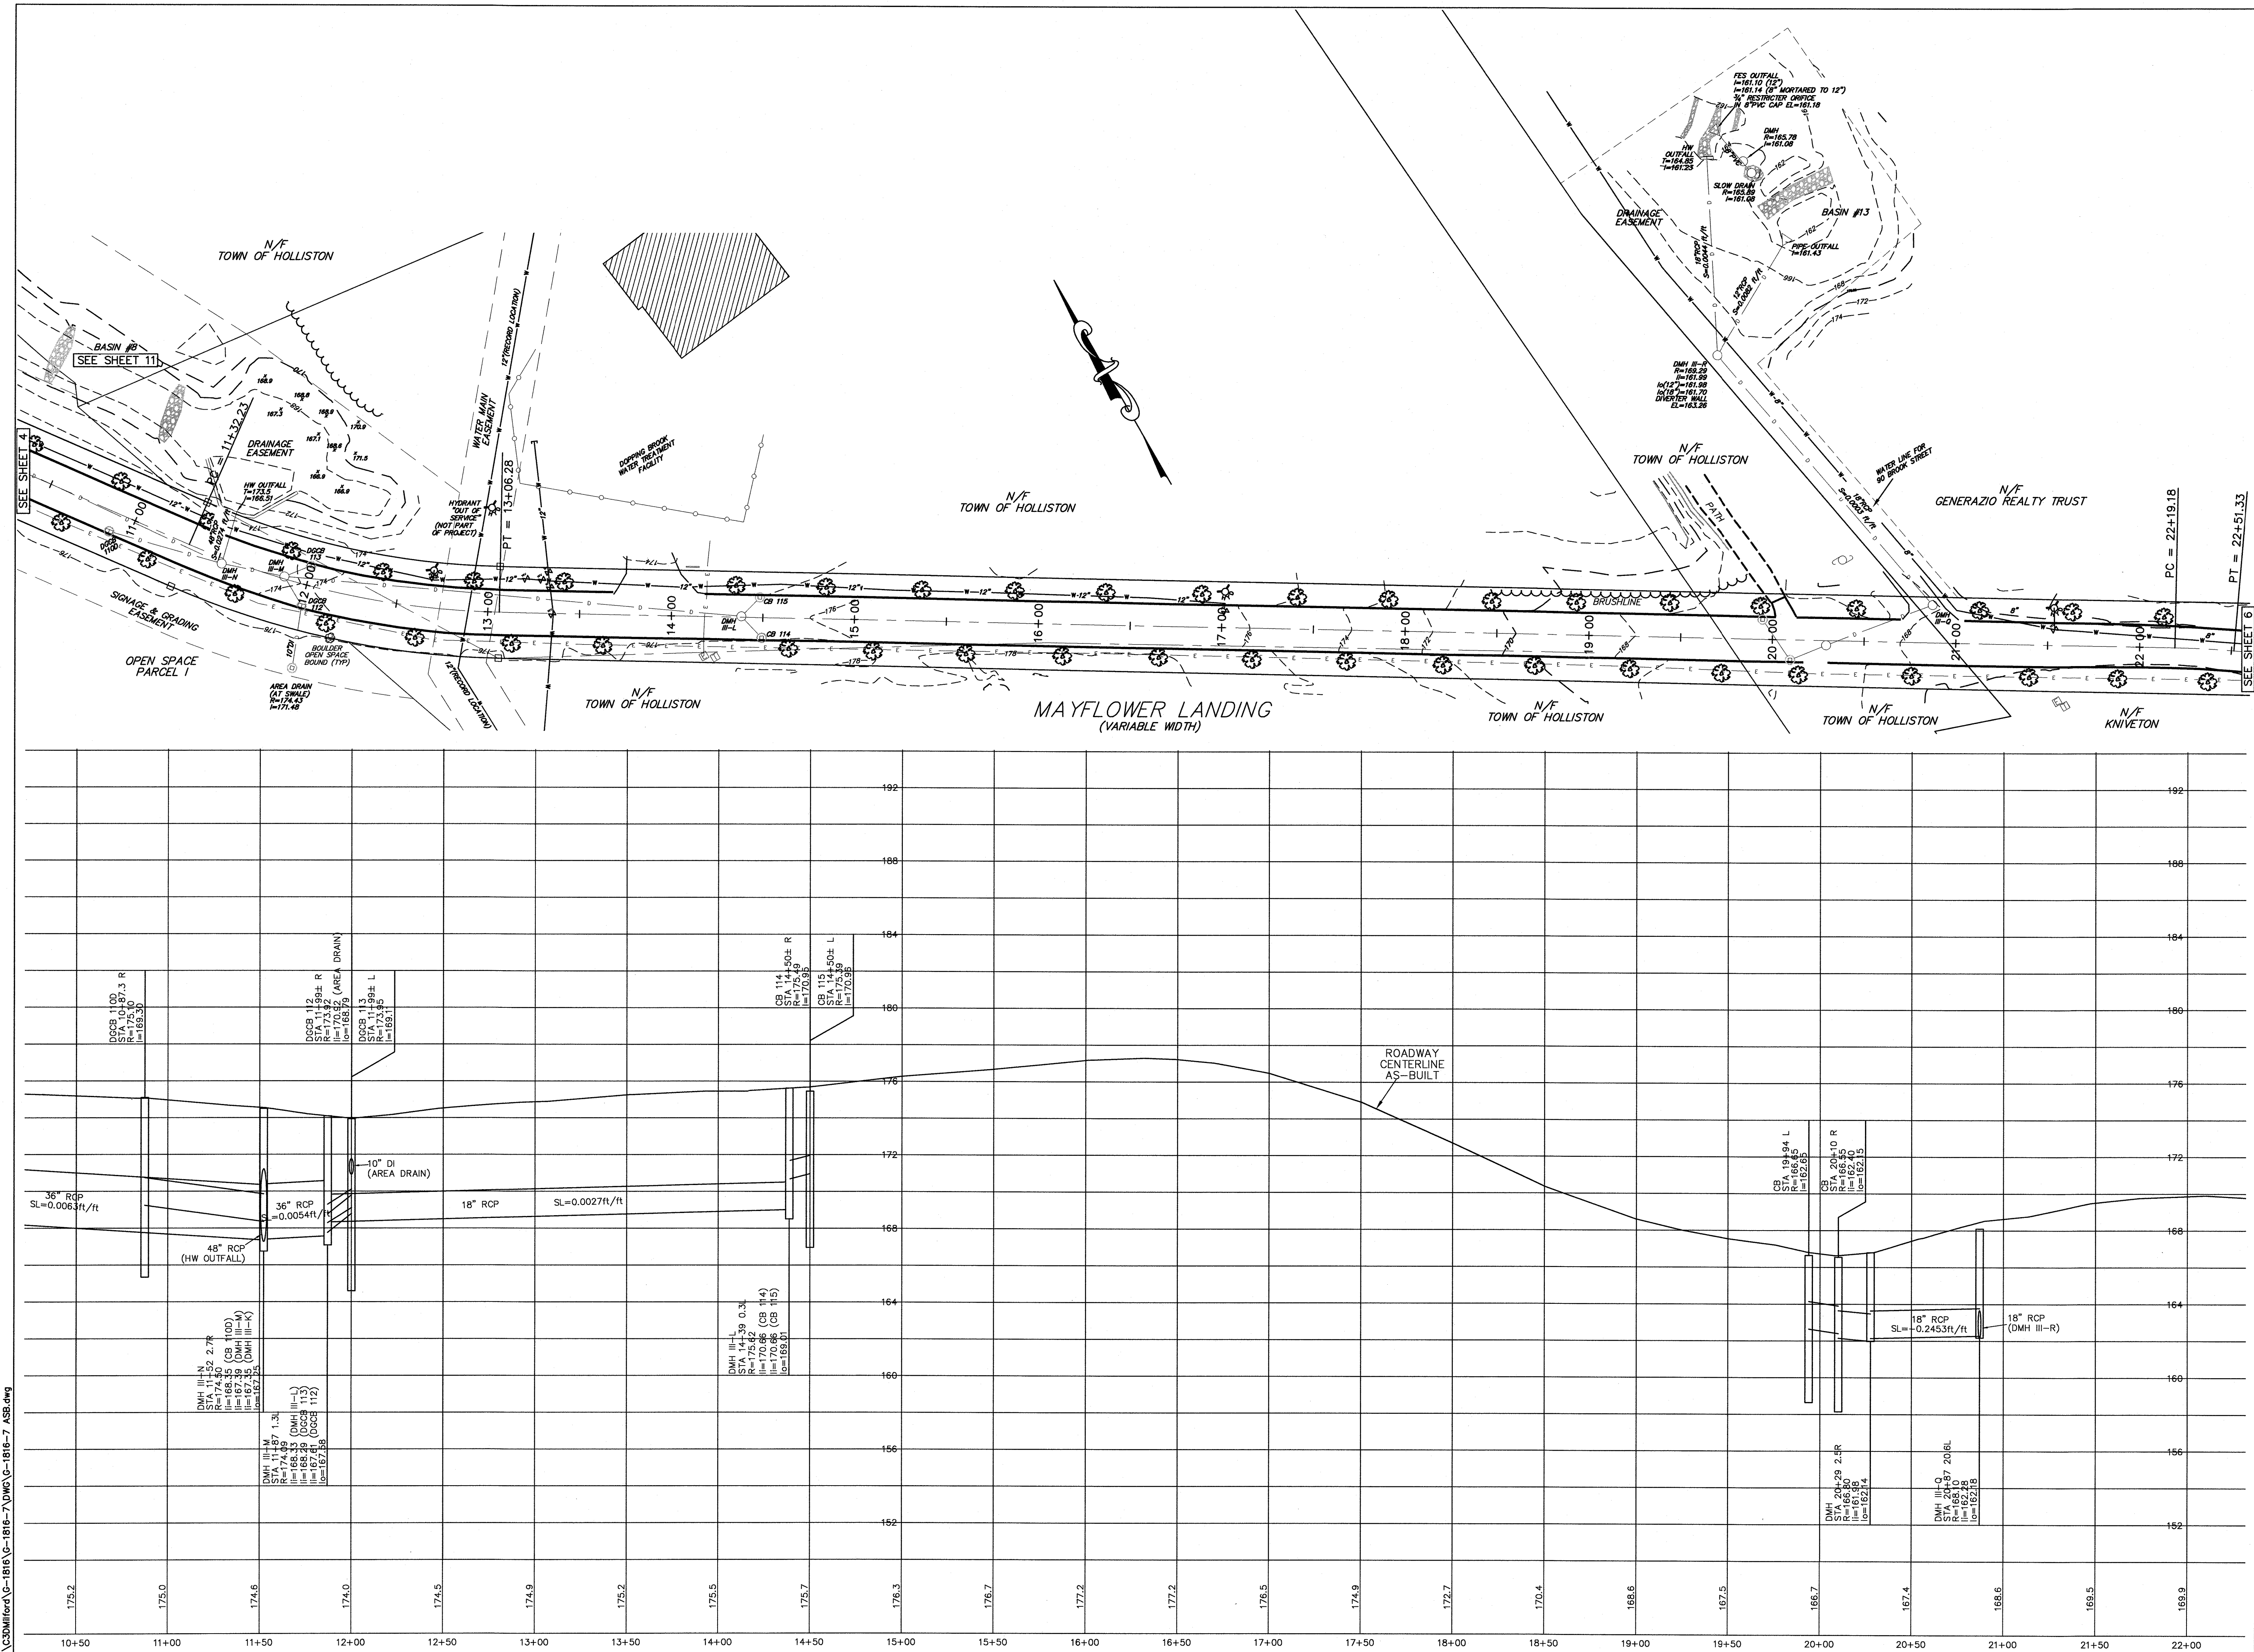

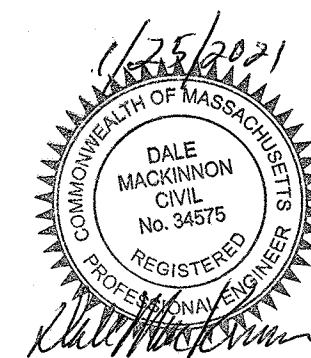

NOTE: CONSTRUCTION ON THIS PROJECT IS SUBJECT TO ANY EASEMENTS, RIGHTS-OF-WAY, RESTRICTIONS, RESERVATIONS OR OTHER LIMITATIONS WHICH MAY BE REVEALED BY AN EXAMINATION OF THE TITLE.



DIG SAFE NOTE:
UTILITIES ARE PLOTTED FROM FIELD LOCATION AND ANY RECORD INFORMATION AVAILABLE, AND SHOULD BE CONSIDERED APPROXIMATE. OTHER UTILITIES MAY EXIST WHICH ARE NOT EVIDENT OR FOR WHICH RECORD INFORMATION WAS NOT AVAILABLE. CONTRACTORS (IN ACCORDANCE WITH MASS.G.L. CHAPTER 82 SECTION 40 AS AMENDED) MUST CONTACT ALL UTILITY COMPANIES BEFORE EXCAVATING AND DRILLING.
CALL "DIG-SAFE" AT 811.
EXISTING LINES OTHER THAN THOSE INDICATED ON THESE DRAWINGS MAY BE ON THE SITE. THE CONTRACTOR IS WARNED TO PROCEED WITH CAUTION WITH ALL WORK, ESPECIALLY EXCAVATION WORK, AND TO MAKE ALL POSSIBLE INVESTIGATIONS AS TO POSSIBLE UNMARKED UTILITY LINES.

NOTES

1. SEE PLAN NO. 1006 OF 1999 AND PLAN NO. 100 OF 2000 RECORDED AT THE MIDDLESEX SOUTH DISTRICT REGISTRY OF DEEDS.

OWNER:
HOLLISTON RESIDENTIAL REALTY, LLC
120 QUARRY DRIVE
MILFORD, MA 01757

"THE HIGHLANDS AT HOLLISTON"
INDIAN CIRCLE
MAYFLOWER LANDING
MOHAWK PATH

AS-BUILT PLAN AND PROFILE OF LAND
IN
Holliston, Massachusetts
SCALE: 40 FEET TO AN INCH HORIZONTAL
4 FEET TO AN INCH VERTICAL
DATE: JANUARY 6, 2017


REVISIONS			
NO.	DATE	DESCRIPTION	BY
1	06-15-17	03-17-17 PLANNER COMMENTS	FJO
2	09-24-18	REVIEW COMMENTS	FJO
3	08-20-19	REVIEW COMMENTS	FJO
4	01-24-20	EASEMENTS	FJO
5	10-15-20	PLANNER COMMENTS	FJO
6	01-21-21	MAYFLOWER WATER UTILITY PROPOSED UTILITY EASEMENT AT MAYFLOWER ROW EASEMENTS	FJO


Guerriere & Halnon, Inc.
Engineering & Land Surveying
333 WEST STREET, MILFORD, MASS. 01757
(508) 473-6630 FAX: (508) 473-8243
www.gandhengineering.com



SHEET 6 OF 13
MAYFLOWER LANDING
STA 22+00 TO STA 30+40.17

FJO

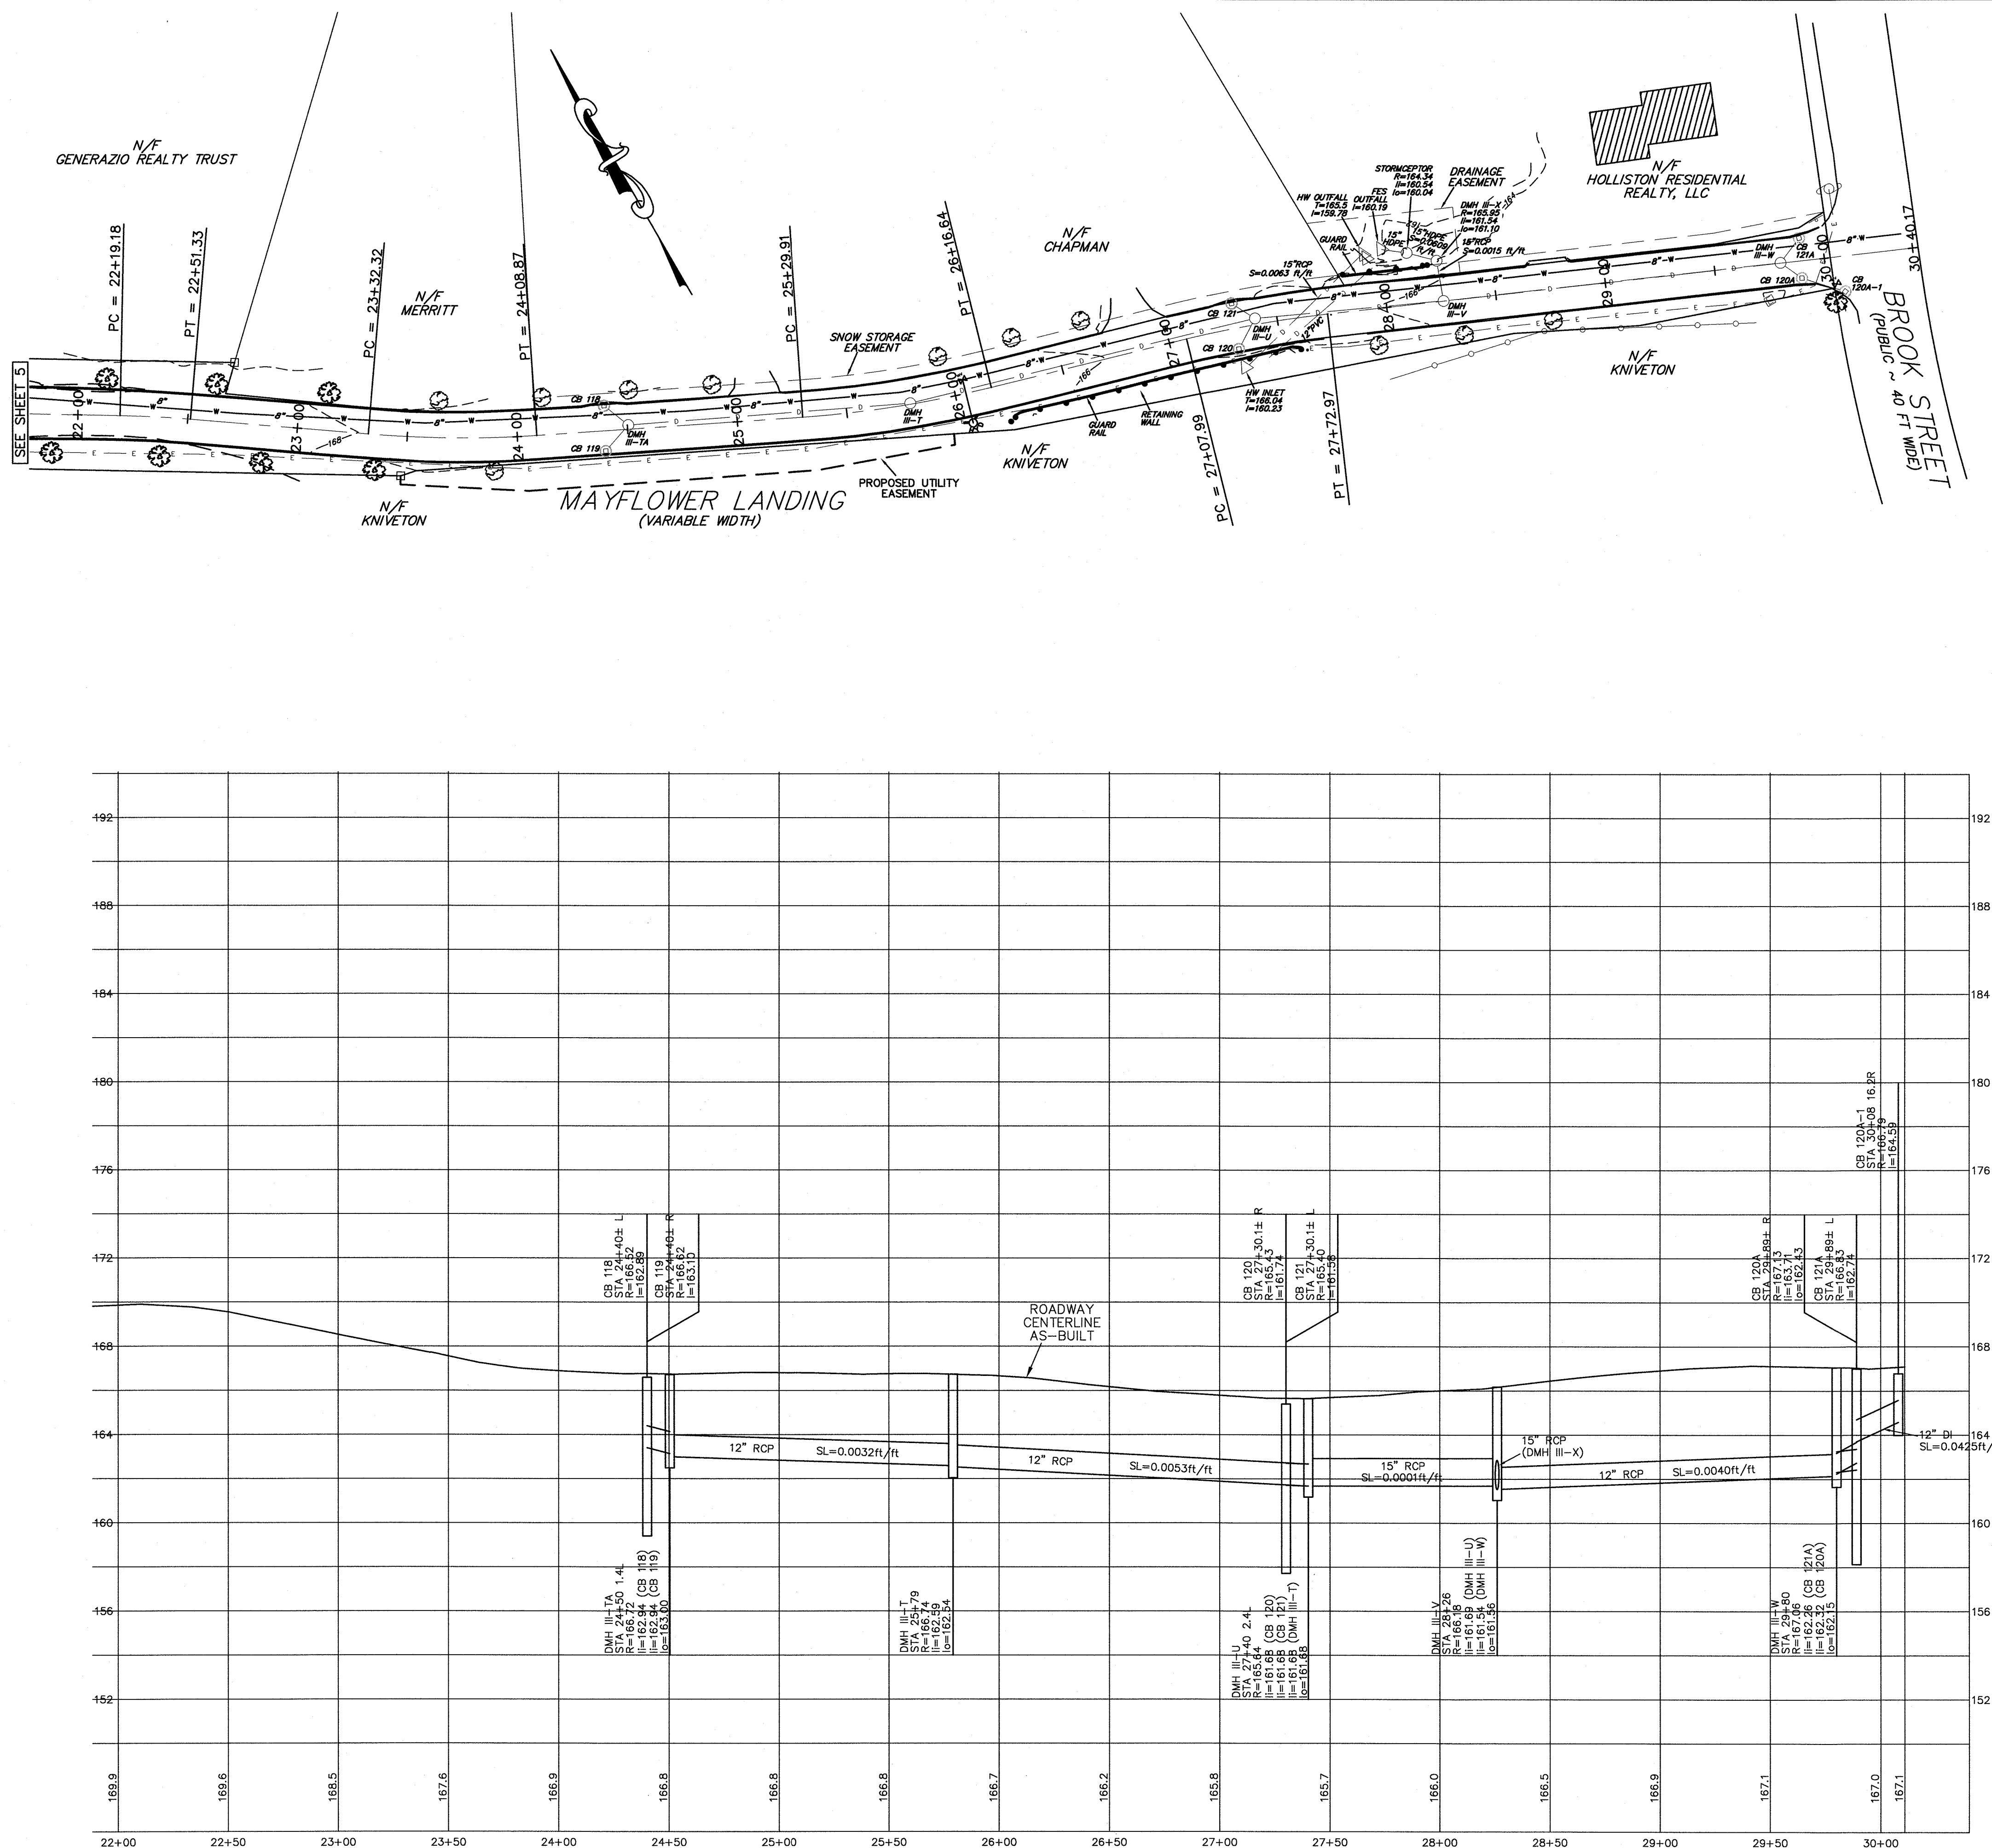

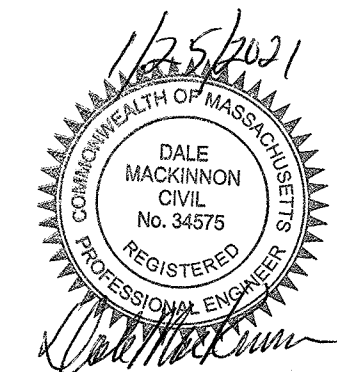

NOTE: CONSTRUCTION ON THIS PROJECT IS SUBJECT TO ANY EASEMENTS, RIGHTS-OF-WAY, RESTRICTIONS, RESERVATIONS OR OTHER LIMITATIONS WHICH MAY BE REVEALED BY AN EXAMINATION OF THE TITLE.

**DIG SAFE NOTE:**

UTILITIES ARE PLOTTED FROM FIELD LOCATION AND ANY RECORD INFORMATION AVAILABLE, AND SHOULD BE CONSIDERED APPROXIMATE. OTHER UTILITIES MAY EXIST WHICH ARE NOT EVIDENT OR FOR WHICH RECORD INFORMATION WAS NOT AVAILABLE. CONTRACTORS (IN ACCORDANCE WITH MASS.G.L. CHAPTER 82, SECTION 40 AS AMENDED) MUST CONTACT ALL UTILITY COMPANIES BEFORE EXCAVATING AND DRILLING. CALL "DIG-SAFE" AT 811.

EXISTING LINES OTHER THAN THOSE INDICATED ON THESE DRAWINGS MAY BE ON THE SITE. THE CONTRACTOR IS WARNED TO PROCEED WITH CAUTION WITH ALL WORK, ESPECIALLY EXCAVATION WORK, AND TO MAKE ALL POSSIBLE INVESTIGATIONS AS TO POSSIBLE UNMARKED UTILITY LINES.

NOTES

1. SEE PLAN NO. 1006 OF 1999 AND PLAN NO. 100 OF 2000 RECORDED AT THE MIDDLESEX SOUTH DISTRICT REGISTRY OF DEEDS.

OWNER:
HOLLISTON RESIDENTIAL REALTY, LLC
120 QUARRY DRIVE
MILFORD, MA 01757

"THE HIGHLANDS AT HOLLISTON"
INDIAN CIRCLE
MAYFLOWER LANDING
MOHAWK PATH


AS-BUILT PLAN AND PROFILE OF LAND
IN
Holliston, Massachusetts
SCALE: 40 FEET TO AN INCH HORIZONTAL
4 FEET TO AN INCH VERTICAL
DATE: JANUARY 6, 2017




REVISIONS			
NO.	DATE	DESCRIPTION	BY
1	06-15-17	03-17-17 PLANNER COMMENTS	FJO
2	09-24-18	REVIEW COMMENTS	FJO
3	08-20-19	REVIEW COMMENTS	FJO
4	01-24-20	EASEMENTS	FJO
5	10-15-20	PLANNER COMMENTS	FJO
6	01-21-21	MAYFLOWER WATER UTILITY PROPOSED UTILITY EASEMENT AT MAYFLOWER	FJO

Guerriere & Halnon, Inc.
Engineering & Land Surveying
333 WEST STREET, MILFORD, MASS. 01757
(508) 473-6630 FAX: (508) 473-8243
www.gandhengineering.com



SHEET 7 OF 13
MOHAWK PATH
STA 39+00 TO STA 50+00

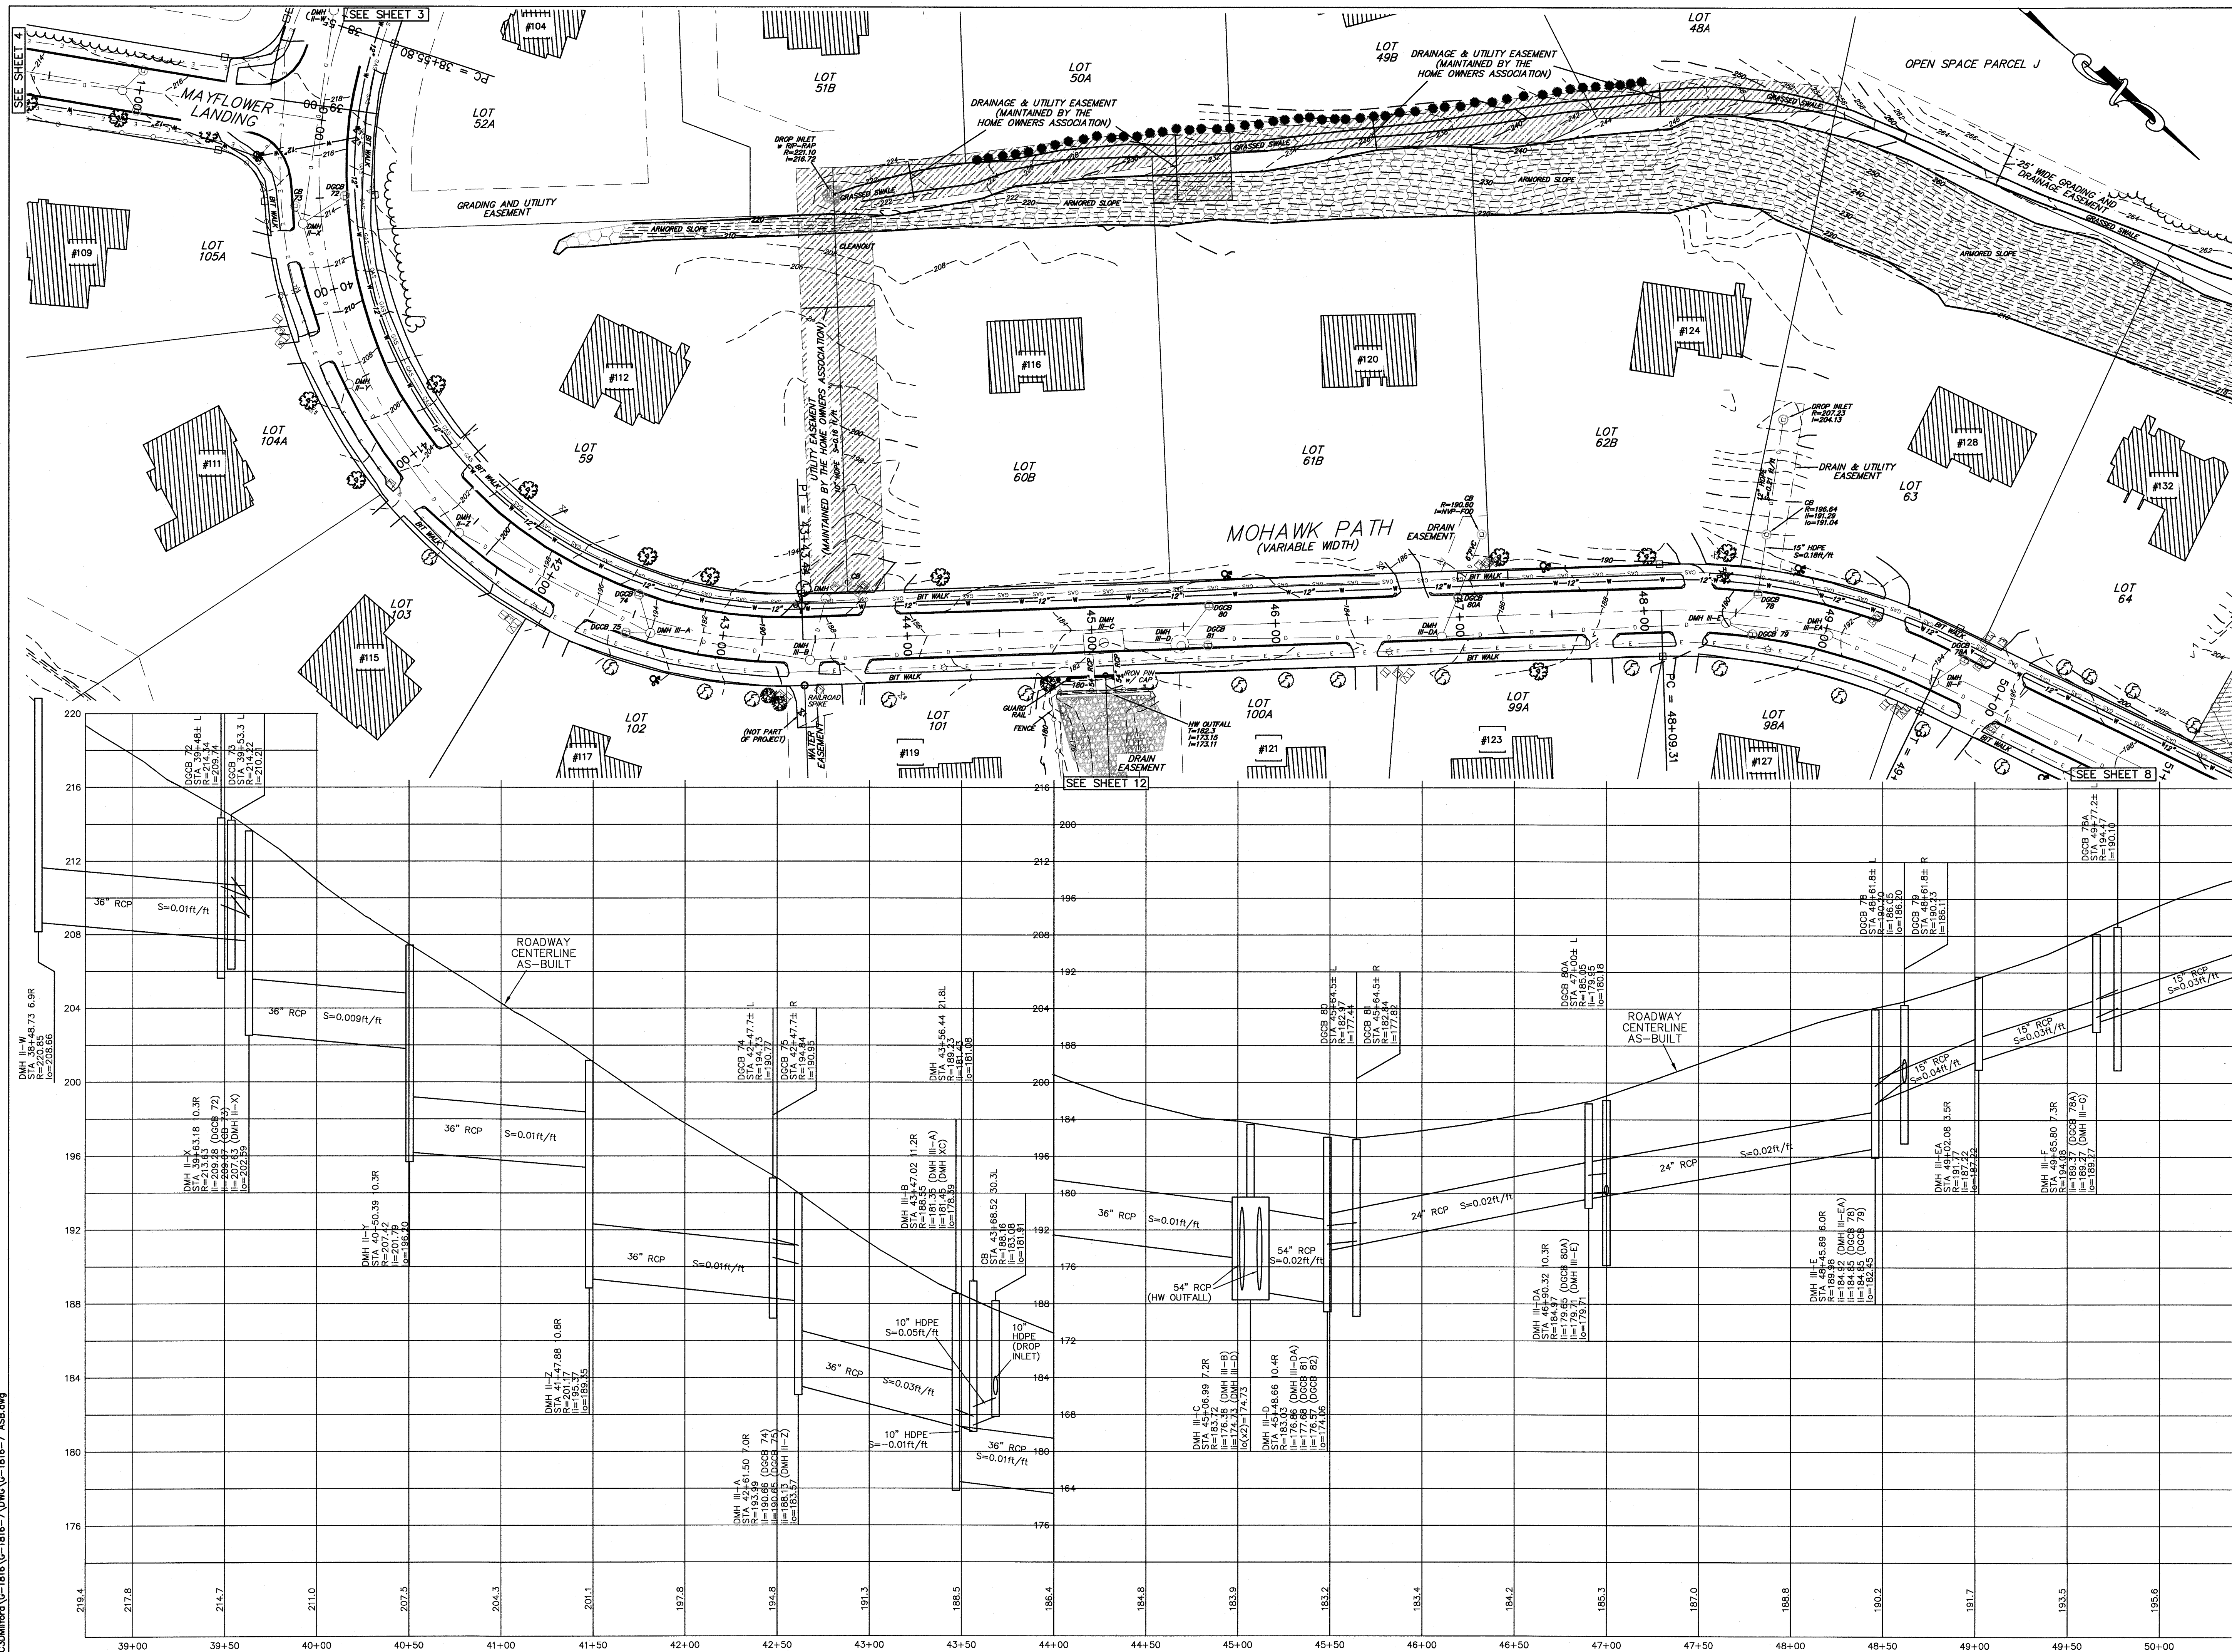

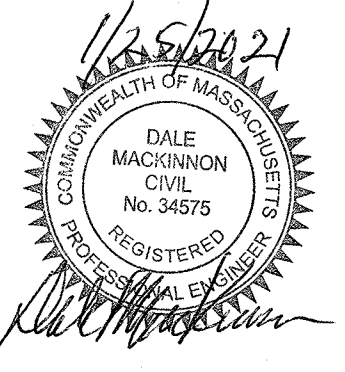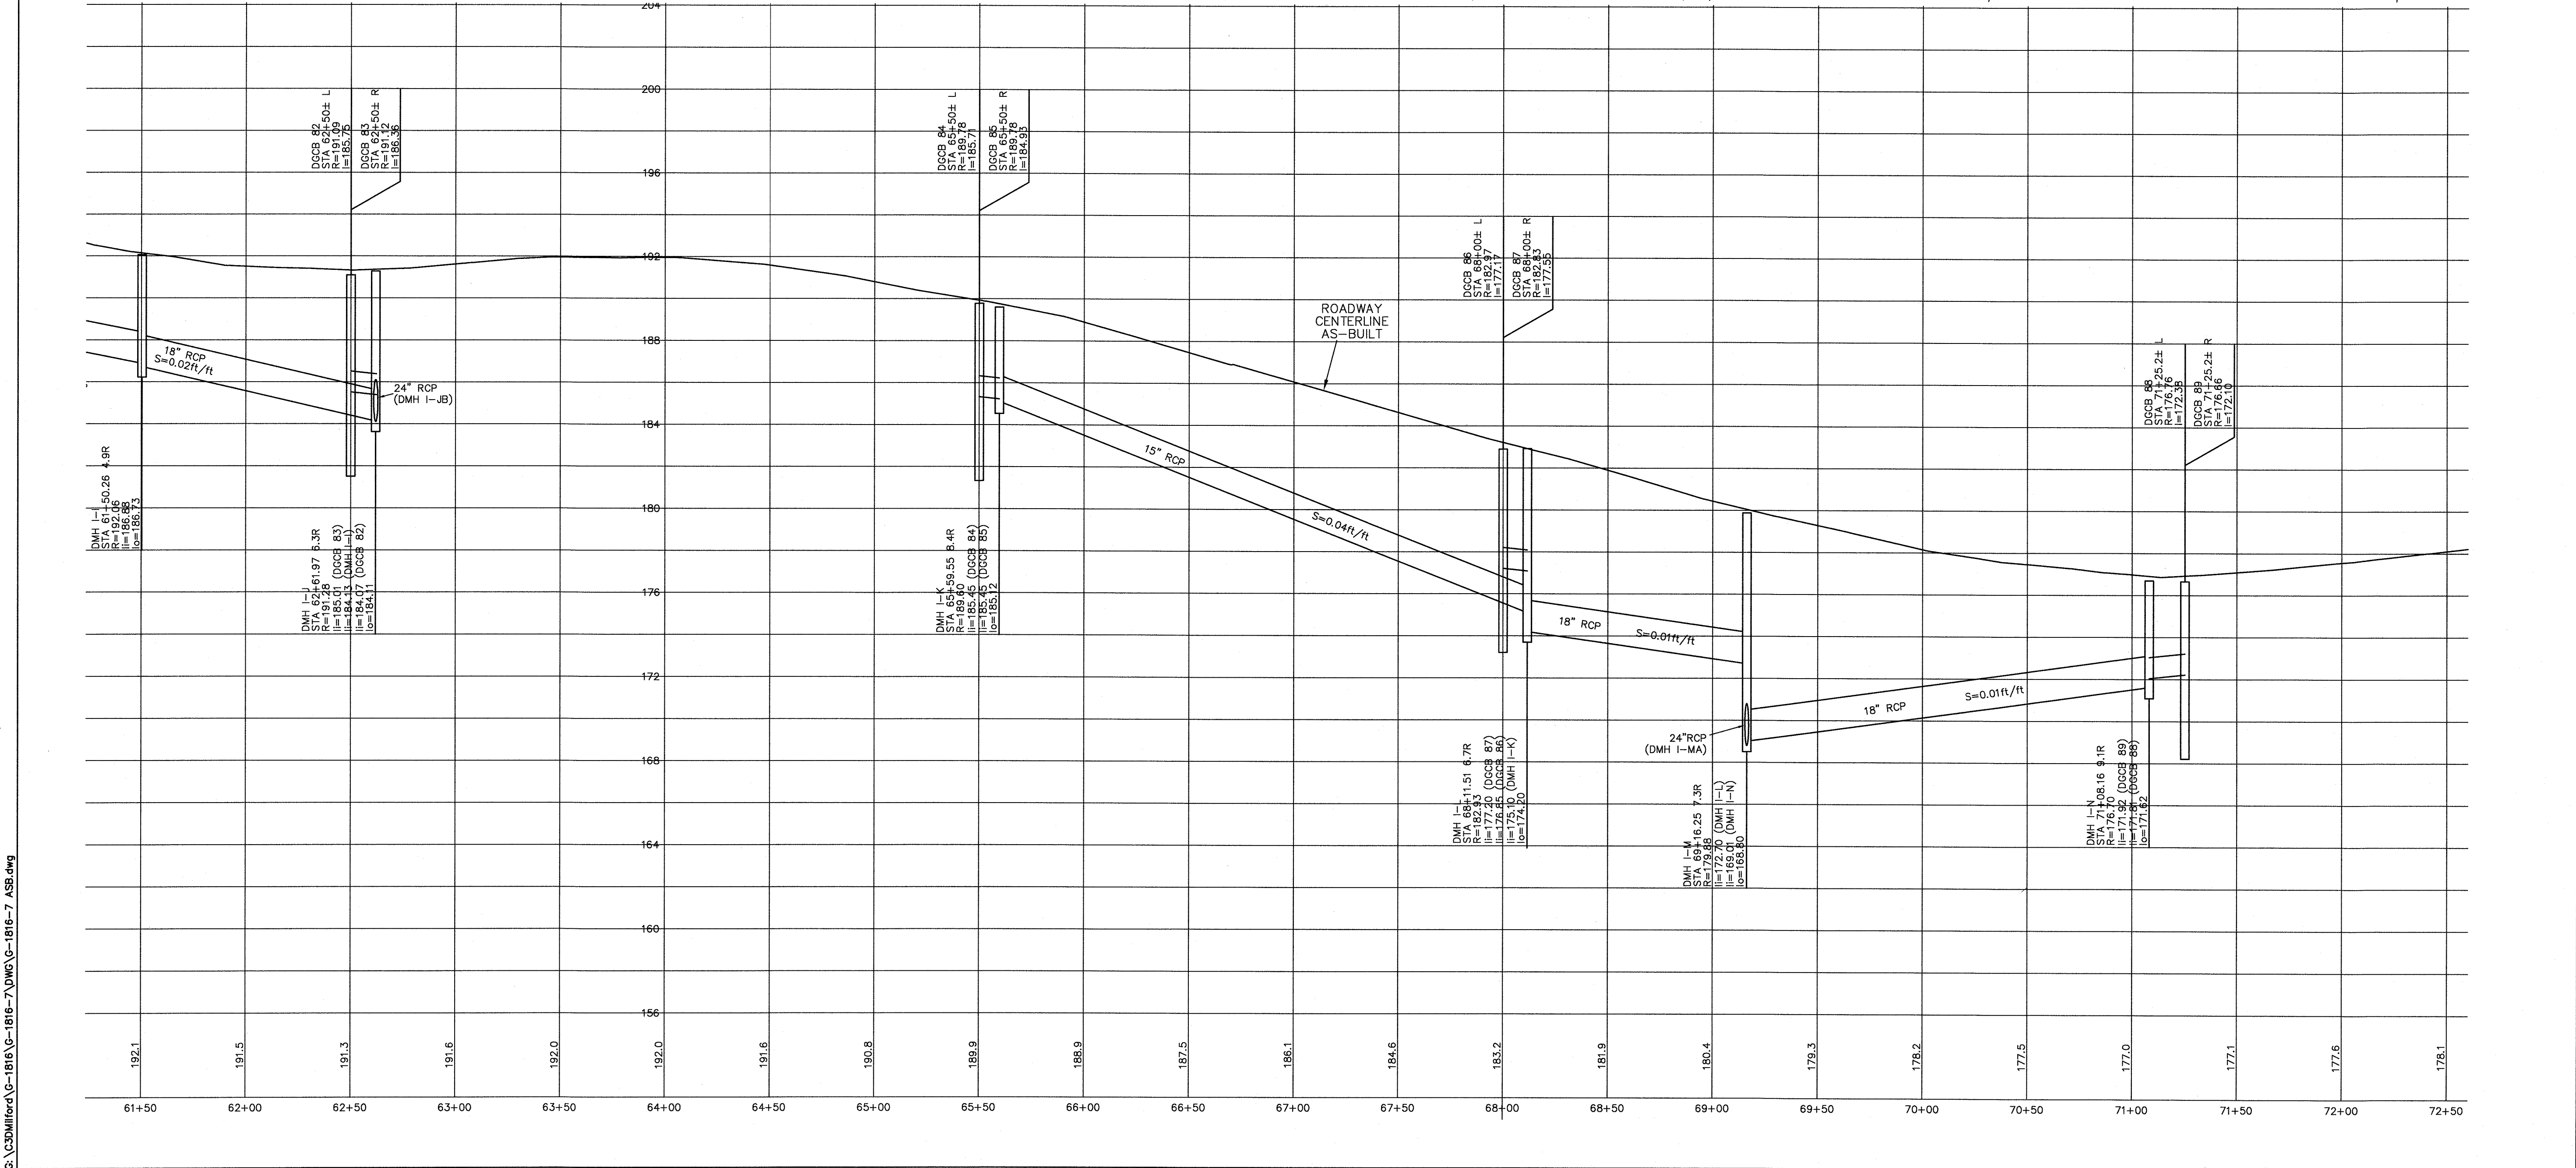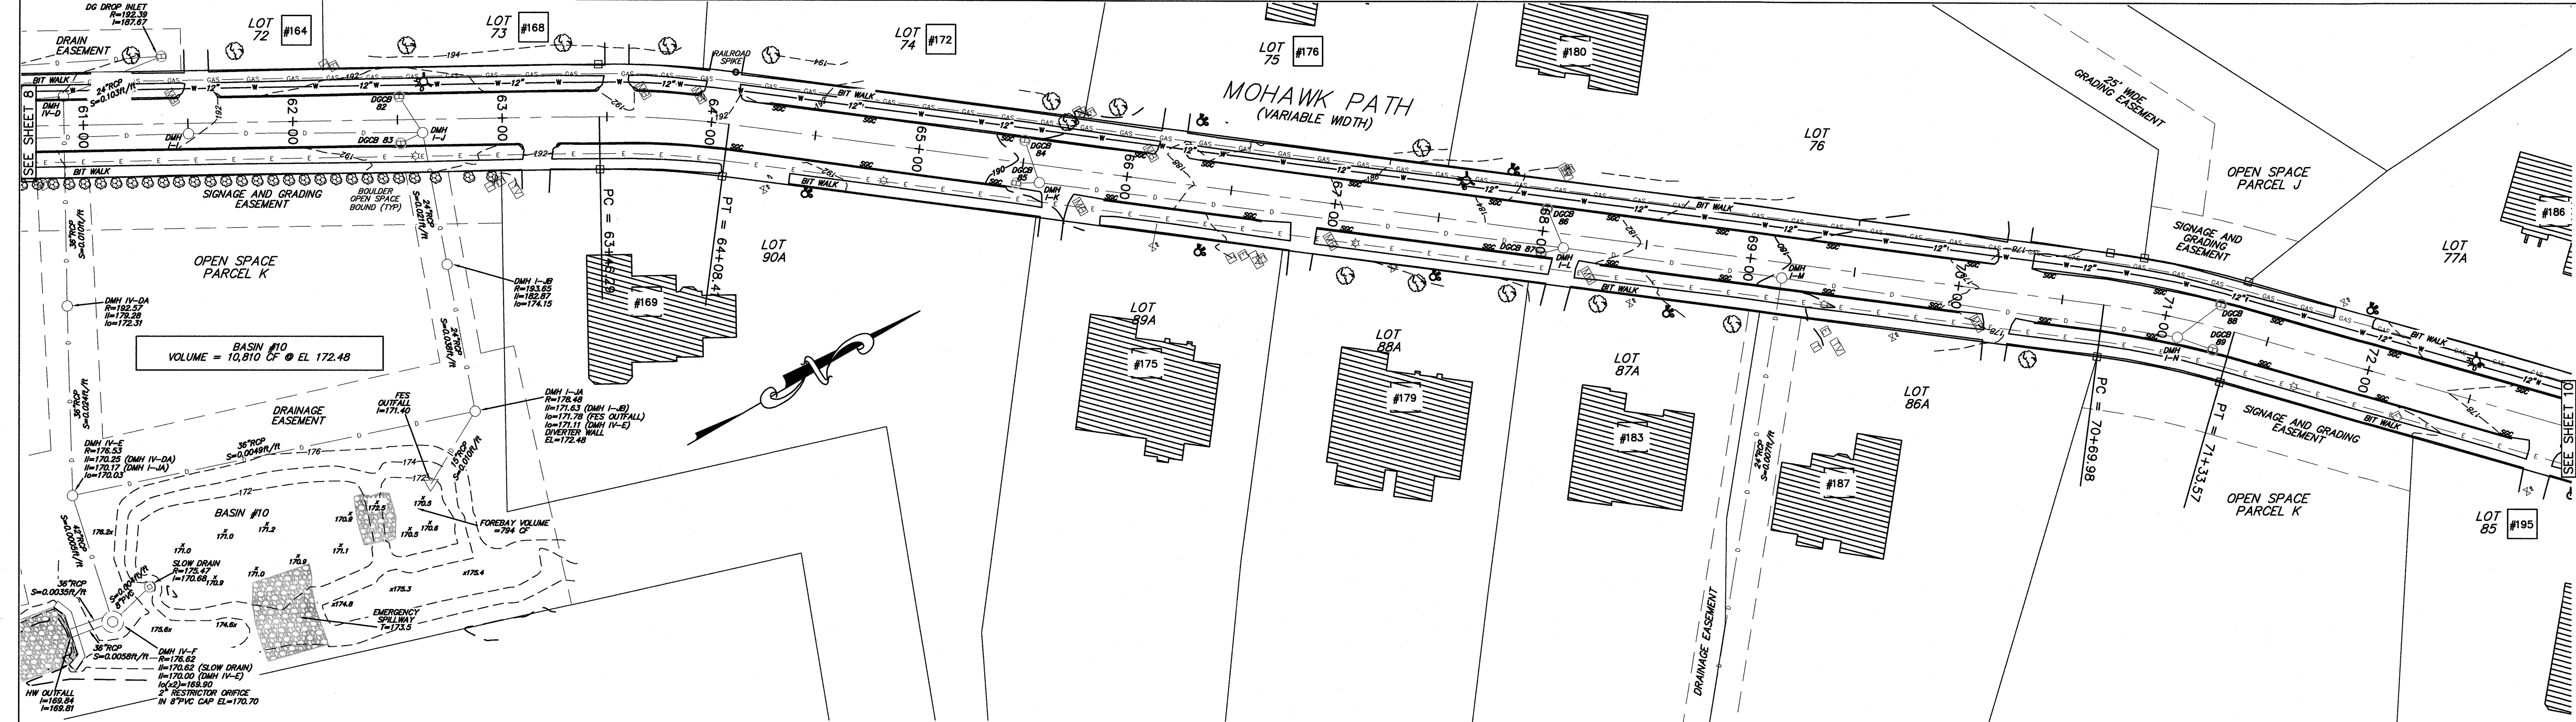

NOTE: CONSTRUCTION ON THIS PROJECT IS SUBJECT TO ANY EASEMENTS, RIGHTS-OF-WAY, RESTRICTIONS, RESERVATIONS OR OTHER LIMITATIONS WHICH MAY BE REVEALED BY AN EXAMINATION OF THE TITLE.



DIG SAFE NOTE:
UTILITIES ARE PLOTTED FROM FIELD LOCATION AND ANY RECORD INFORMATION AVAILABLE, AND SHOULD BE CONSIDERED APPROXIMATE. OTHER UTILITIES MAY EXIST WHICH ARE NOT EVIDENT OR FOR WHICH RECORD INFORMATION WAS NOT AVAILABLE. CONTRACTORS (IN ACCORDANCE WITH MASS.G.L. CHAPTER 82 SECTION 40 AS AMENDED) MUST CONTACT ALL UTILITY COMPANIES BEFORE EXCAVATING AND DRILLING. CALL "DIG-SAFE" AT 811.
EXISTING LINES OTHER THAN THOSE INDICATED ON THESE DRAWINGS MAY BE ON THE SITE. THE CONTRACTOR IS WARNED TO PROCEED WITH CAUTION WITH ALL WORK, ESPECIALLY EXCAVATION WORK, AND TO MAKE ALL POSSIBLE INVESTIGATIONS AS TO POSSIBLE UNMARKED UTILITY LINES.

NOTES

1. SEE PLAN NO. 1006 OF 1999 AND PLAN NO. 100 OF 2000 RECORDED AT THE MIDDLESEX SOUTH DISTRICT REGISTRY OF DEEDS.


OWNER:
HOLLISTON RESIDENTIAL REALTY, LLC
120 QUARRY DRIVE
MILFORD, MA 01757

"THE HIGHLANDS AT HOLLISTON"
INDIAN CIRCLE
MAYFLOWER LANDING
MOHAWK PATH




AS-BUILT PLAN AND PROFILE OF LAND
IN
Holliston, Massachusetts
SCALE: 40 FEET TO AN INCH HORIZONTAL
4 FEET TO AN INCH VERTICAL
DATE: JANUARY 6, 2017

REVISIONS			
NO.	DATE	DESCRIPTION	BY
1	06-15-17	03-17-17 PLANNER COMMENTS	FJO
2	08-24-18	REVIEW COMMENTS	FJO
3	08-20-19	REVIEW COMMENTS	FJO
4	01-24-20	EASEMENTS	FJO
5	10-15-20	PLANNER COMMENTS	FJO
6	01-21-21	MAYFLOWER WATER UTILITY PROPOSED UTILITY EASEMENT AT MAYFLOWER	FJO

Guerriere & Halnon, Inc.
Engineering & Land Surveying
333 WEST STREET, MILFORD, MASS. 01757
(508) 473-6630 FAX: (508) 473-8243
www.gandhengineering.com

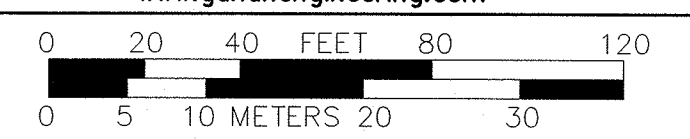

SHEET 9 OF 13
MOHAWK PATH
STA 61+50 TO STA 72+50

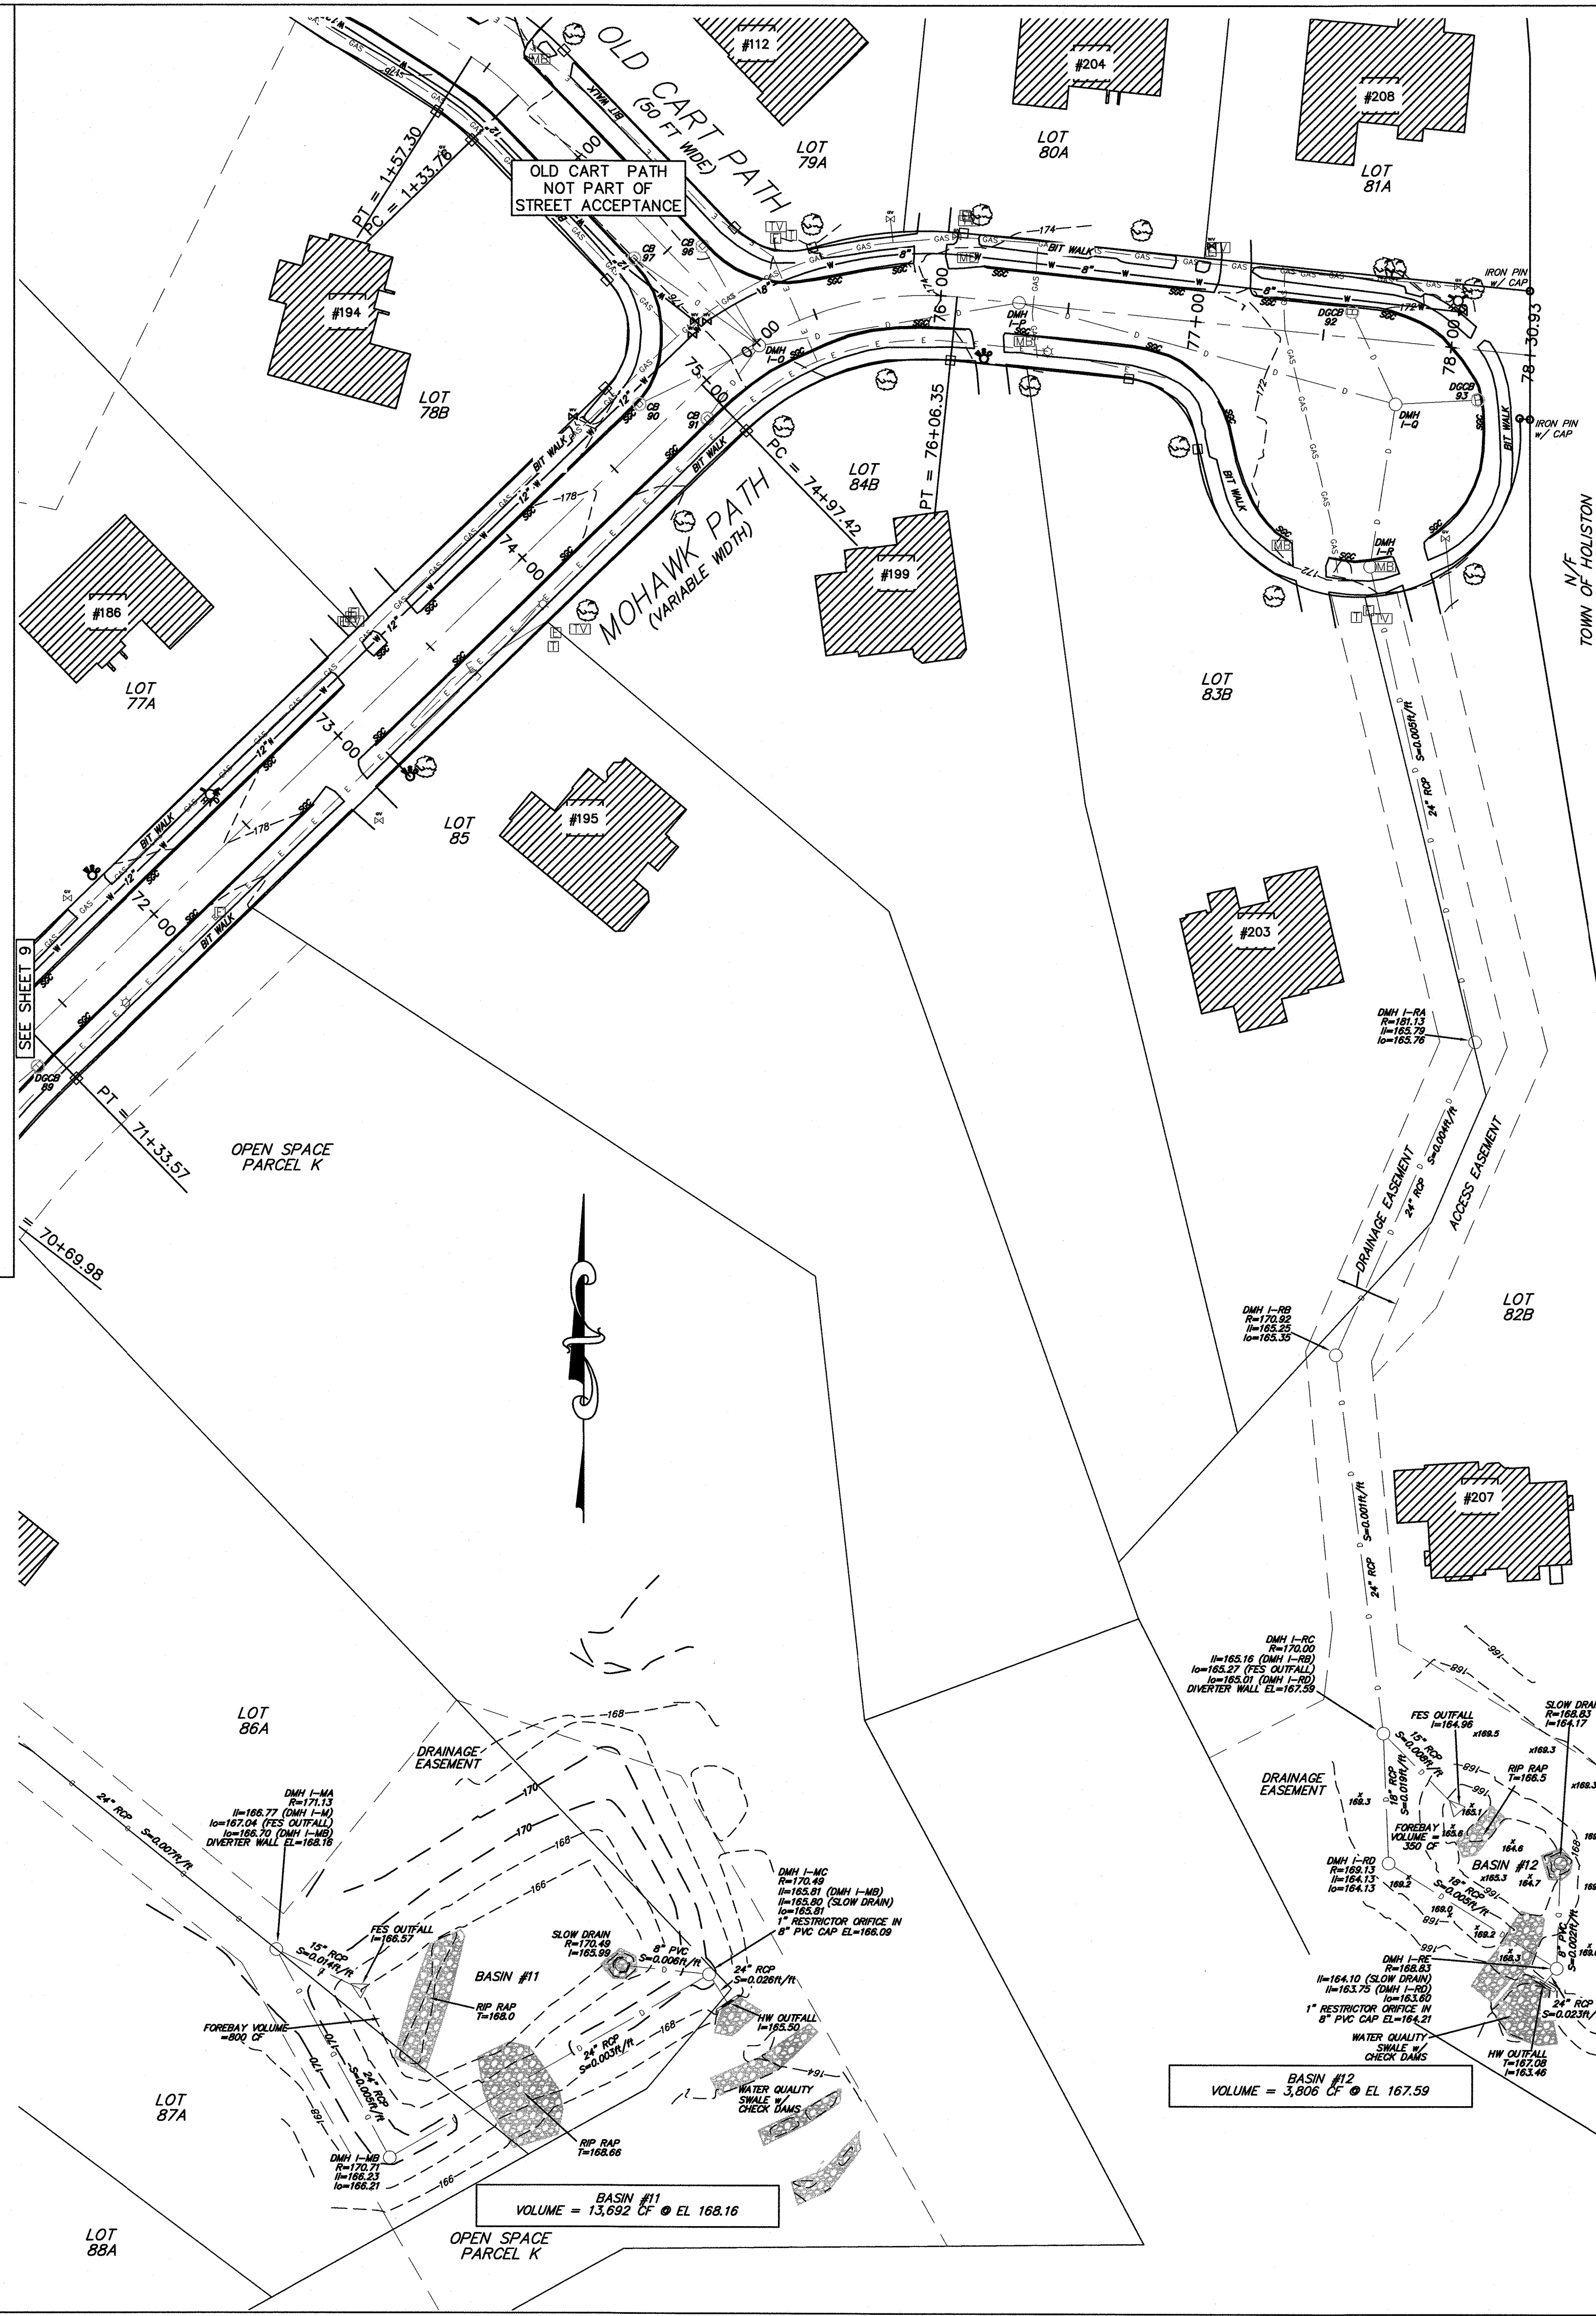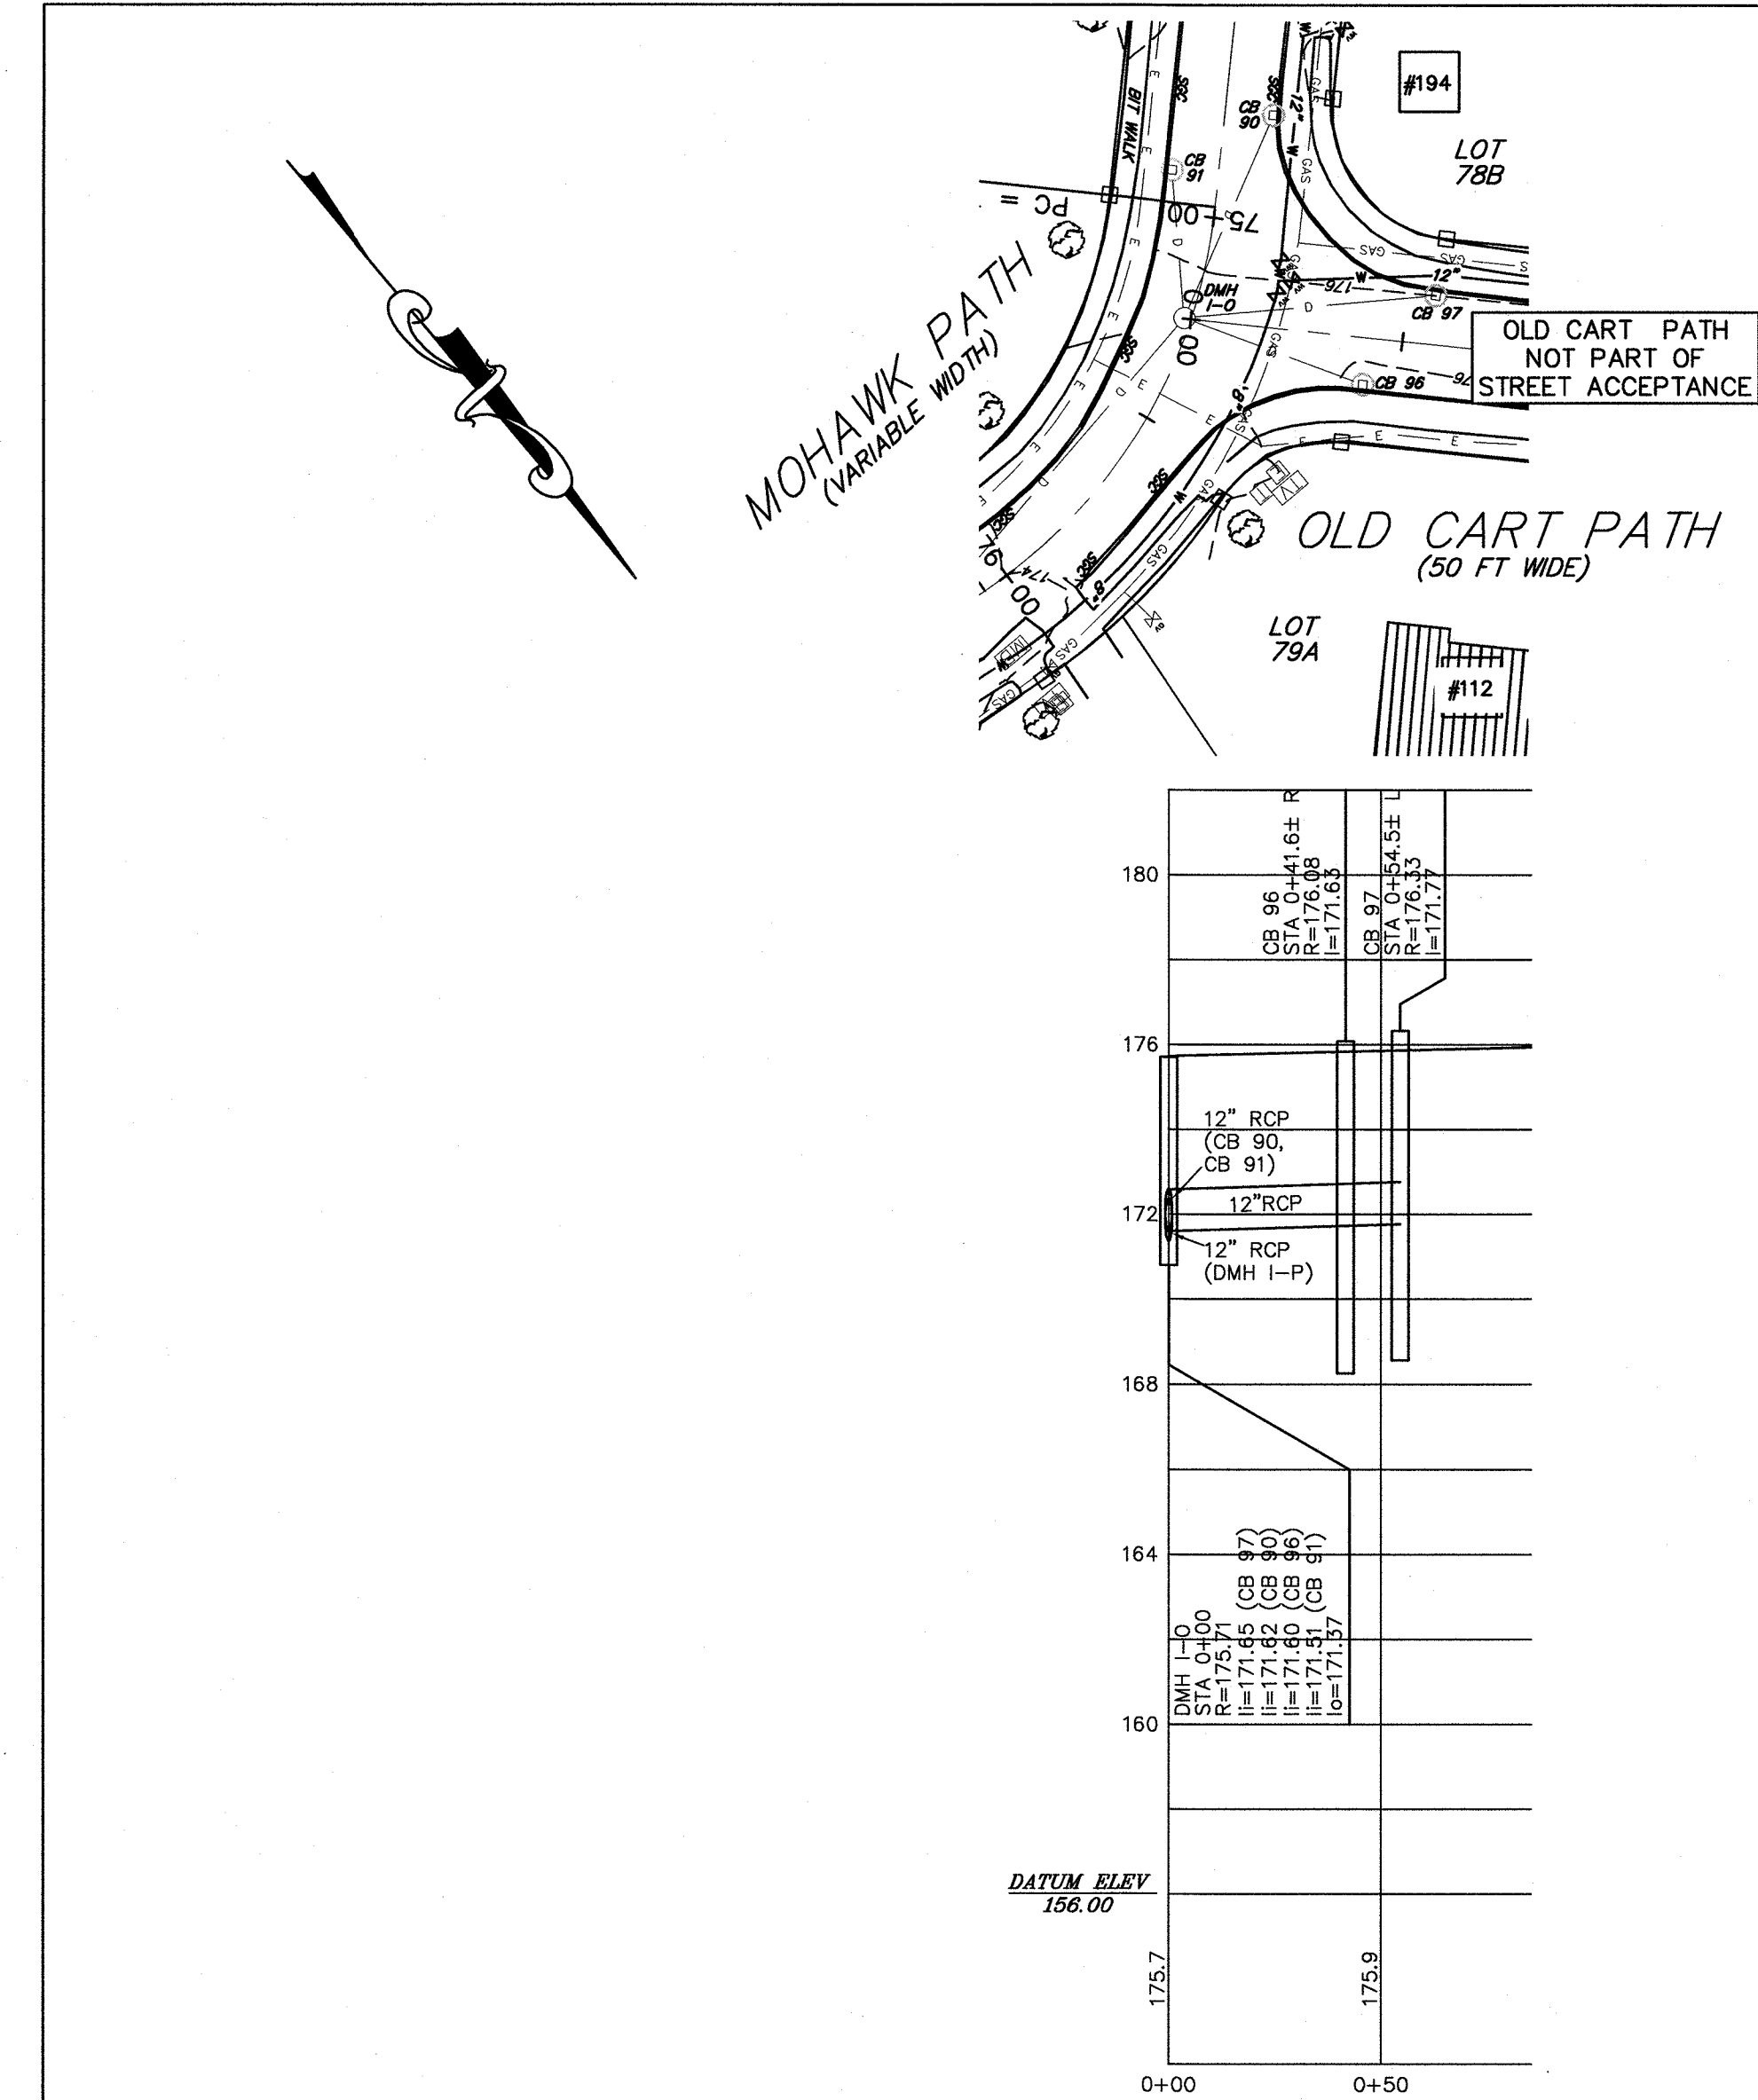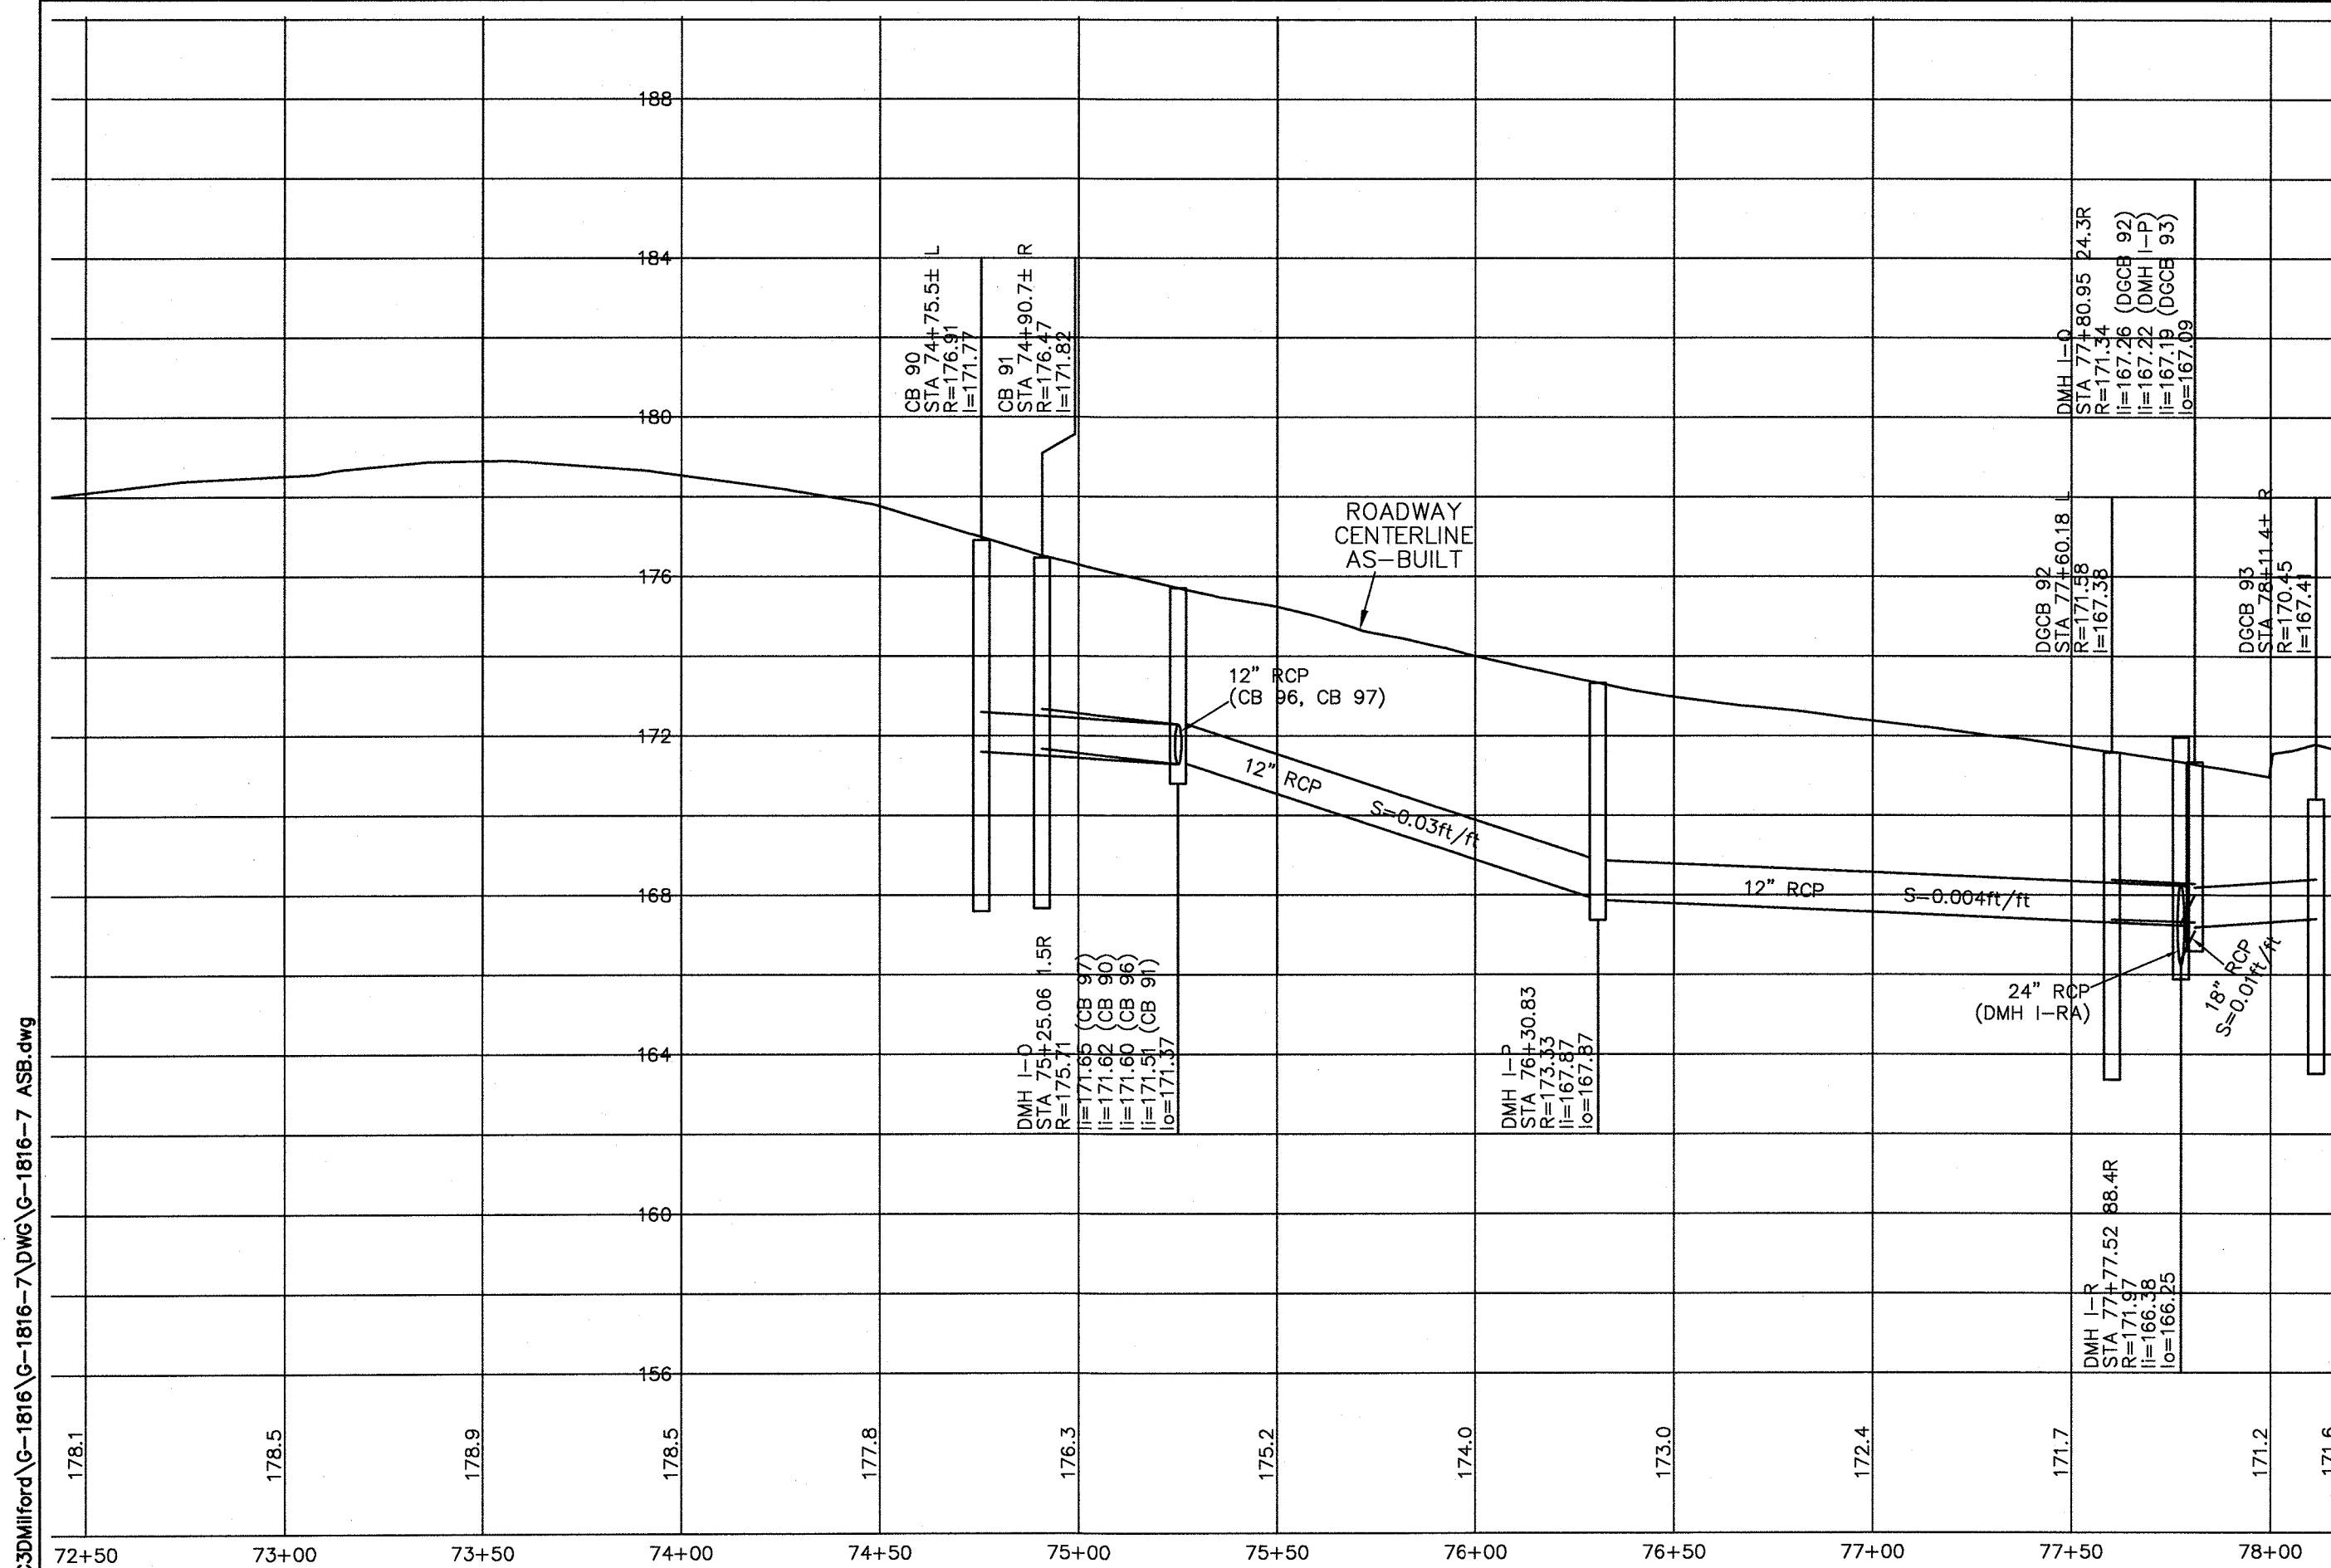

NOTE: CONSTRUCTION ON THIS PROJECT IS SUBJECT TO ANY EASEMENTS, RIGHTS-OF-WAY, RESTRICTIONS, RESERVATIONS OR OTHER LIMITATIONS WHICH MAY BE REVEALED BY AN EXAMINATION OF THE TITLE.



DIG SAFE NOTE:
UTILITIES ARE PLOTTED FROM FIELD LOCATION AND ANY RECORD INFORMATION AVAILABLE, AND SHOULD BE CONSIDERED APPROXIMATE. OTHER UTILITIES MAY EXIST WHICH ARE NOT EVIDENT OR FOR WHICH RECORD INFORMATION WAS NOT AVAILABLE. CONTRACTORS (IN ACCORDANCE WITH MASS.G.L. CHAPTER 22 SECTION 40 AS AMENDED) MUST CONTACT ALL UTILITY COMPANIES BEFORE EXCAVATING AND DRILLING. CALL "DIG-SAFE" AT 811.
EXISTING LINES OTHER THAN THOSE INDICATED ON THESE DRAWINGS MAY BE ON THE SITE. THE CONTRACTOR IS WARNED TO PROCEED WITH CAUTION WITH ALL WORK, ESPECIALLY EXCAVATION WORK, AND TO MAKE ALL POSSIBLE INVESTIGATIONS AS TO POSSIBLE UNMARKED UTILITY LINES.

NOTES

1. SEE PLAN NO. 1006 OF 1999 AND PLAN NO. 100 OF 2000 RECORDED AT THE MIDDLESEX SOUTH DISTRICT REGISTRY OF DEEDS.

OWNER:
HOLLISTON RESIDENTIAL REALTY, LLC
120 QUARRY DRIVE
MILFORD, MA 01757

"THE HIGHLANDS AT HOLLISTON"
INDIAN CIRCLE
MAYFLOWER LANDING
MOHAWK PATH

AS-BUILT PLAN AND PROFILE
OF LAND


Holliston, Massachusetts

SCALE: 40 FEET TO AN INCH HORIZONTAL
4 FEET TO AN INCH VERTICAL


DATE: JANUARY 6, 2017

NO.	DATE	DESCRIPTION	BY
1	06-15-17	03-17-17 PLANNER COMMENTS	FJO
2	09-24-18	REVIEW COMMENTS	FJO
3	08-20-19	REVIEW COMMENTS	FJO
4	01-24-20	EASEMENTS	FJO
5	10-15-20	PLANNER COMMENTS	FJO
6	01-21-21	MAYFLOWER WATER UTILITY PROPOSED UTILITY EASEMENT AT MAYFLOWER	FJO

Guerriere & Halnon, Inc.
Engineering & Land Surveying
333 WEST STREET, MILFORD, MASS. 01757
(508) 473-6630 FAX: (508) 473-8243
www.gandhengineering.com

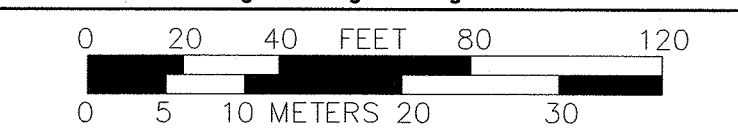

SHEET 10 OF 13
MOHAWK PATH STA 72+50 TO STA 78+30.93
OLD CART PATH STA 0+00 TO STA 2+85.66

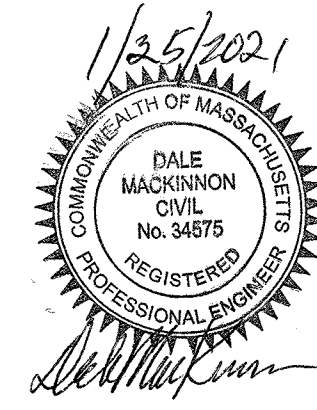

NOTE: CONSTRUCTION ON THIS PROJECT IS SUBJECT TO ANY EASEMENTS, RIGHTS-OF-WAY, RESTRICTIONS, RESERVATIONS OR OTHER LIMITATIONS WHICH MAY BE REVEALED BY AN EXAMINATION OF THE TITLE.



DIG SAFE NOTE:
UTILITIES ARE PLOTTED FROM FIELD LOCATION AND ANY RECORD INFORMATION AVAILABLE, AND SHOULD BE CONSIDERED APPROXIMATE. OTHER UTILITIES MAY EXIST WHICH ARE NOT EVIDENT OR FOR WHICH RECORD INFORMATION WAS NOT AVAILABLE. CONTRACTORS (IN ACCORDANCE WITH MASS.G.L. CHAPTER 86, SECTION 40 AS AMENDED) MUST CONTACT ALL UTILITY COMPANIES BEFORE EXCAVATING AND DRILLING. CALL "DIG-SAFE" AT 811.
EXISTING LINES OTHER THAN THOSE INDICATED ON THESE DRAWINGS MAY BE ON THE SITE. THE CONTRACTOR IS WARNED TO PROCEED WITH CAUTION WITH ALL WORK, ESPECIALLY EXCAVATION WORK, AND TO MAKE ALL POSSIBLE INVESTIGATIONS AS TO POSSIBLE UNMARKED UTILITY LINES.

NOTES

1. SEE PLAN NO. 1006 OF 1999 AND PLAN NO. 100 OF 2000 RECORDED AT THE MIDDLESEX SOUTH DISTRICT REGISTRY OF DEEDS.

OWNER:
HOLLISTON RESIDENTIAL REALTY, LLC
120 QUARRY DRIVE
MILFORD, MA 01757

"THE HIGHLANDS AT HOLLISTON"
INDIAN CIRCLE
MAYFLOWER LANDING
MOHAWK PATH

AS-BUILT PLAN AND PROFILE OF LAND
IN
Holliston, Massachusetts
SCALE: 40 FEET TO AN INCH HORIZONTAL
4 FEET TO AN INCH VERTICAL
DATE: JANUARY 6, 2017

REVISIONS			
NO.	DATE	DESCRIPTION	BY
1	06-15-17	03-17-17 PLANNER COMMENTS	FJO
2	09-24-18	REVIEW COMMENTS	FJO
3	08-20-19	REVIEW COMMENTS	FJO
4	01-24-20	EASEMENTS	FJO
5	10-15-20	PLANNER COMMENTS	FJO
6	01-21-21	MAYFLOWER WATER UTILITY PROPOSED UTILITY EASEMENT AT MAYFLOWER LANDING	FJO





Guerriere & Halnon, Inc.
Engineering & Land Surveying
333 WEST STREET, MILFORD, MASS. 01757
(508) 473-6630 FAX: (508) 473-8243
www.gandhengineering.com



SHEET 11 OF 13
DETENTION BASIN 8

FJO

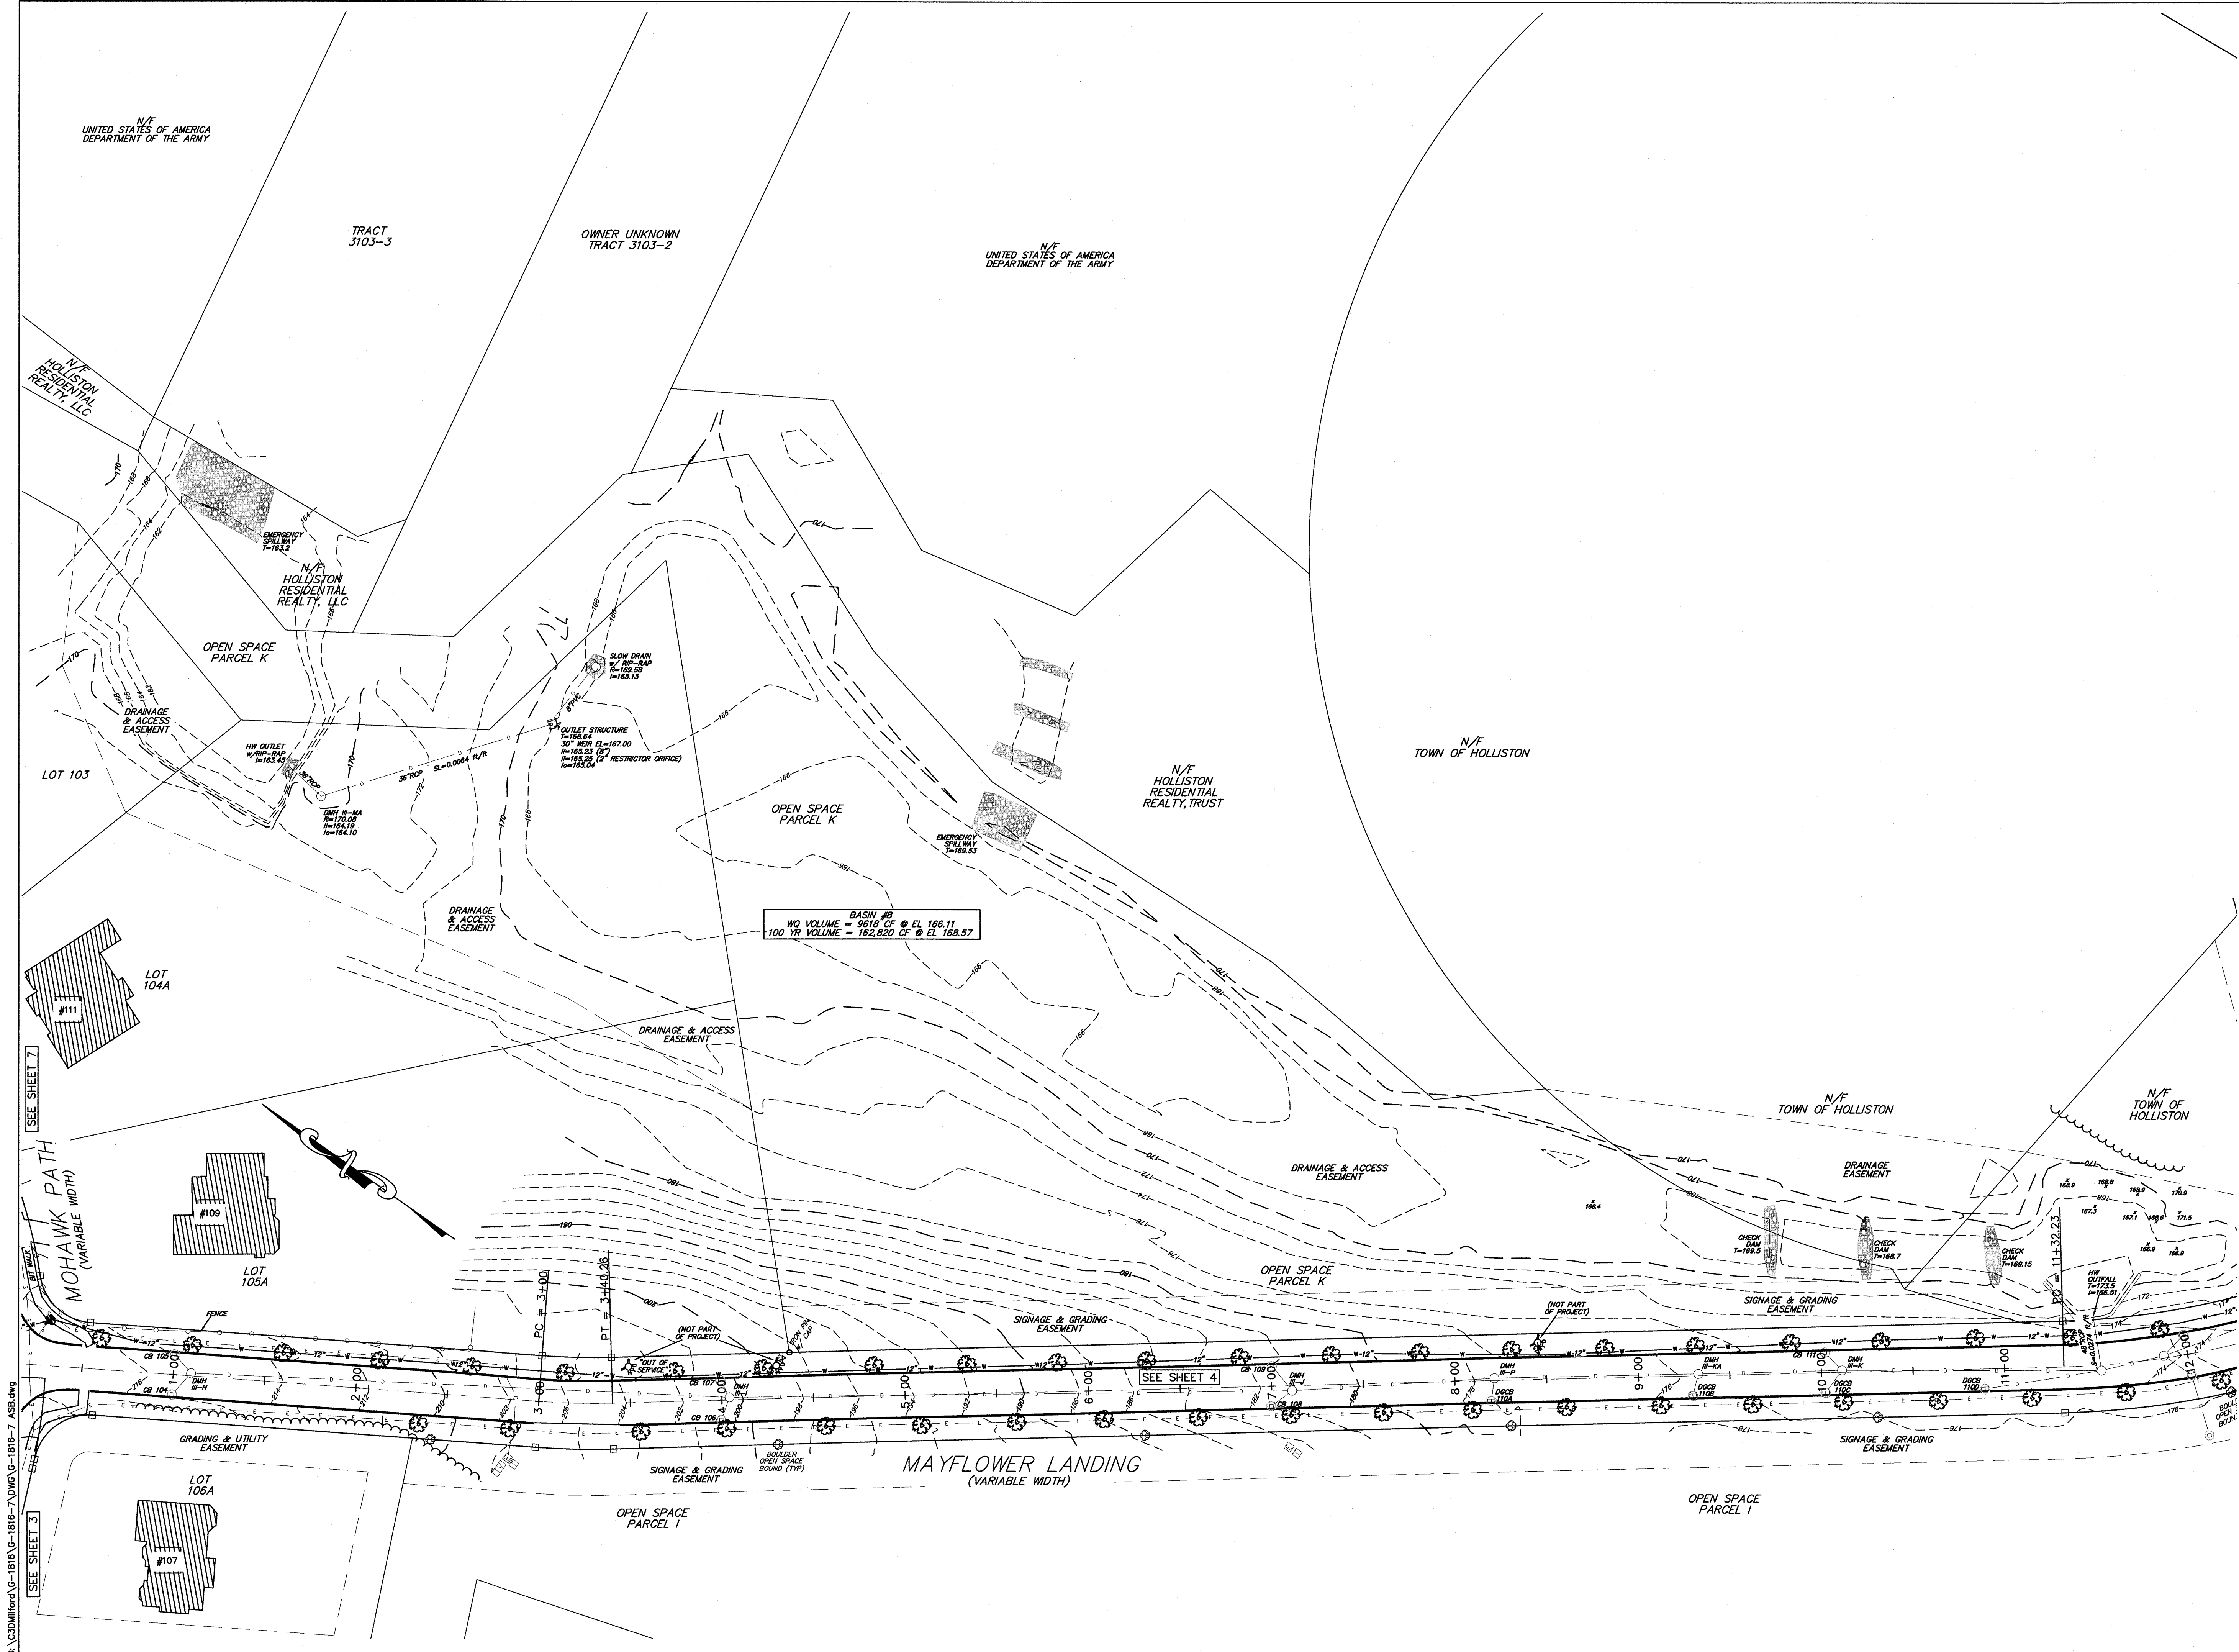

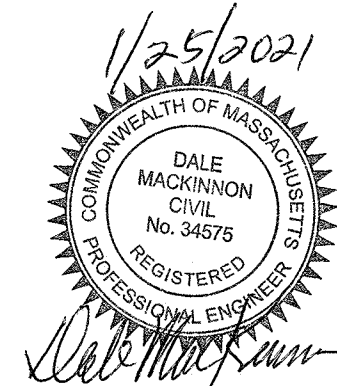

NOTE: CONSTRUCTION ON THIS PROJECT IS SUBJECT TO ANY EASEMENTS, RIGHTS-OF-WAY, RESTRICTIONS, RESERVATIONS OR OTHER LIMITATIONS WHICH MAY BE REVEALED BY AN EXAMINATION OF THE TITLE.



DIG SAFE NOTE:

UTILITIES ARE PLOTTED FROM FIELD LOCATION AND ANY RECORD INFORMATION AVAILABLE, AND SHOULD BE CONSIDERED APPROXIMATE. OTHER UTILITIES MAY EXIST WHICH ARE NOT EVIDENT OR FOR WHICH RECORD INFORMATION WAS NOT AVAILABLE. CONTRACTORS (IN ACCORDANCE WITH MASS. CH. 149A, § 27B) MUST CONTACT ALL UTILITY COMPANIES BEFORE EXCAVATING AND DRILLING. CALL "DIG-SAFE" AT 811. EXISTING LINES OTHER THAN THOSE INDICATED ON THESE DRAWINGS MAY BE ON THE SITE. THE CONTRACTOR IS WARNED TO PROCEED WITH CAUTION WITH ALL WORK, ESPECIALLY EXCAVATION WORK, AND TO MAKE ALL POSSIBLE INVESTIGATIONS AS TO POSSIBLE UNMARKED UTILITY LINES.

NOTES

1. SEE PLAN NO. 1006 OF 1999 AND PLAN NO. 100 OF 2000 RECORDED AT THE MIDDLESEX SOUTH DISTRICT REGISTRY OF DEEDS.

OWNER:
HOLLISTON RESIDENTIAL REALTY, LLC
120 QUARRY DRIVE
MILFORD, MA 01757

"THE HIGHLANDS AT HOLLISTON"
INDIAN CIRCLE
MAYFLOWER LANDING
MOHAWK PATH


AS-BUILT PLAN AND PROFILE
OF LAND
IN

Holliston, Massachusetts

SCALE: 40 FEET TO AN INCH HORIZONTAL
4 FEET TO AN INCH VERTICAL
DATE: JANUARY 6, 2017


REVISIONS			
NO.	DATE	DESCRIPTION	BY
1	06-15-17	03-17-17 PLANNER COMMENTS	FJO
2	09-24-18	REVIEW COMMENTS	FJO
3	08-20-19	REVIEW COMMENTS	FJO
4	01-24-20	EASEMENTS	FJO
5	10-15-20	PLANNER COMMENTS	FJO
6	01-21-21	MAYFLOWER WATER UTILITY PROPOSED UTILITY EASEMENT AT MAYFLOWER HOA EASEMENTS	FJO

Guerriere & Halnon, Inc.
Engineering & Land Surveying
333 WEST STREET, MILFORD, MASS. 01757
(508) 473-6630 FAX: (508) 473-8243
www.gandhengineering.com

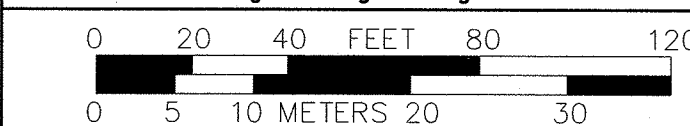

SHEET 12 OF 13
BASIN 7

FJO

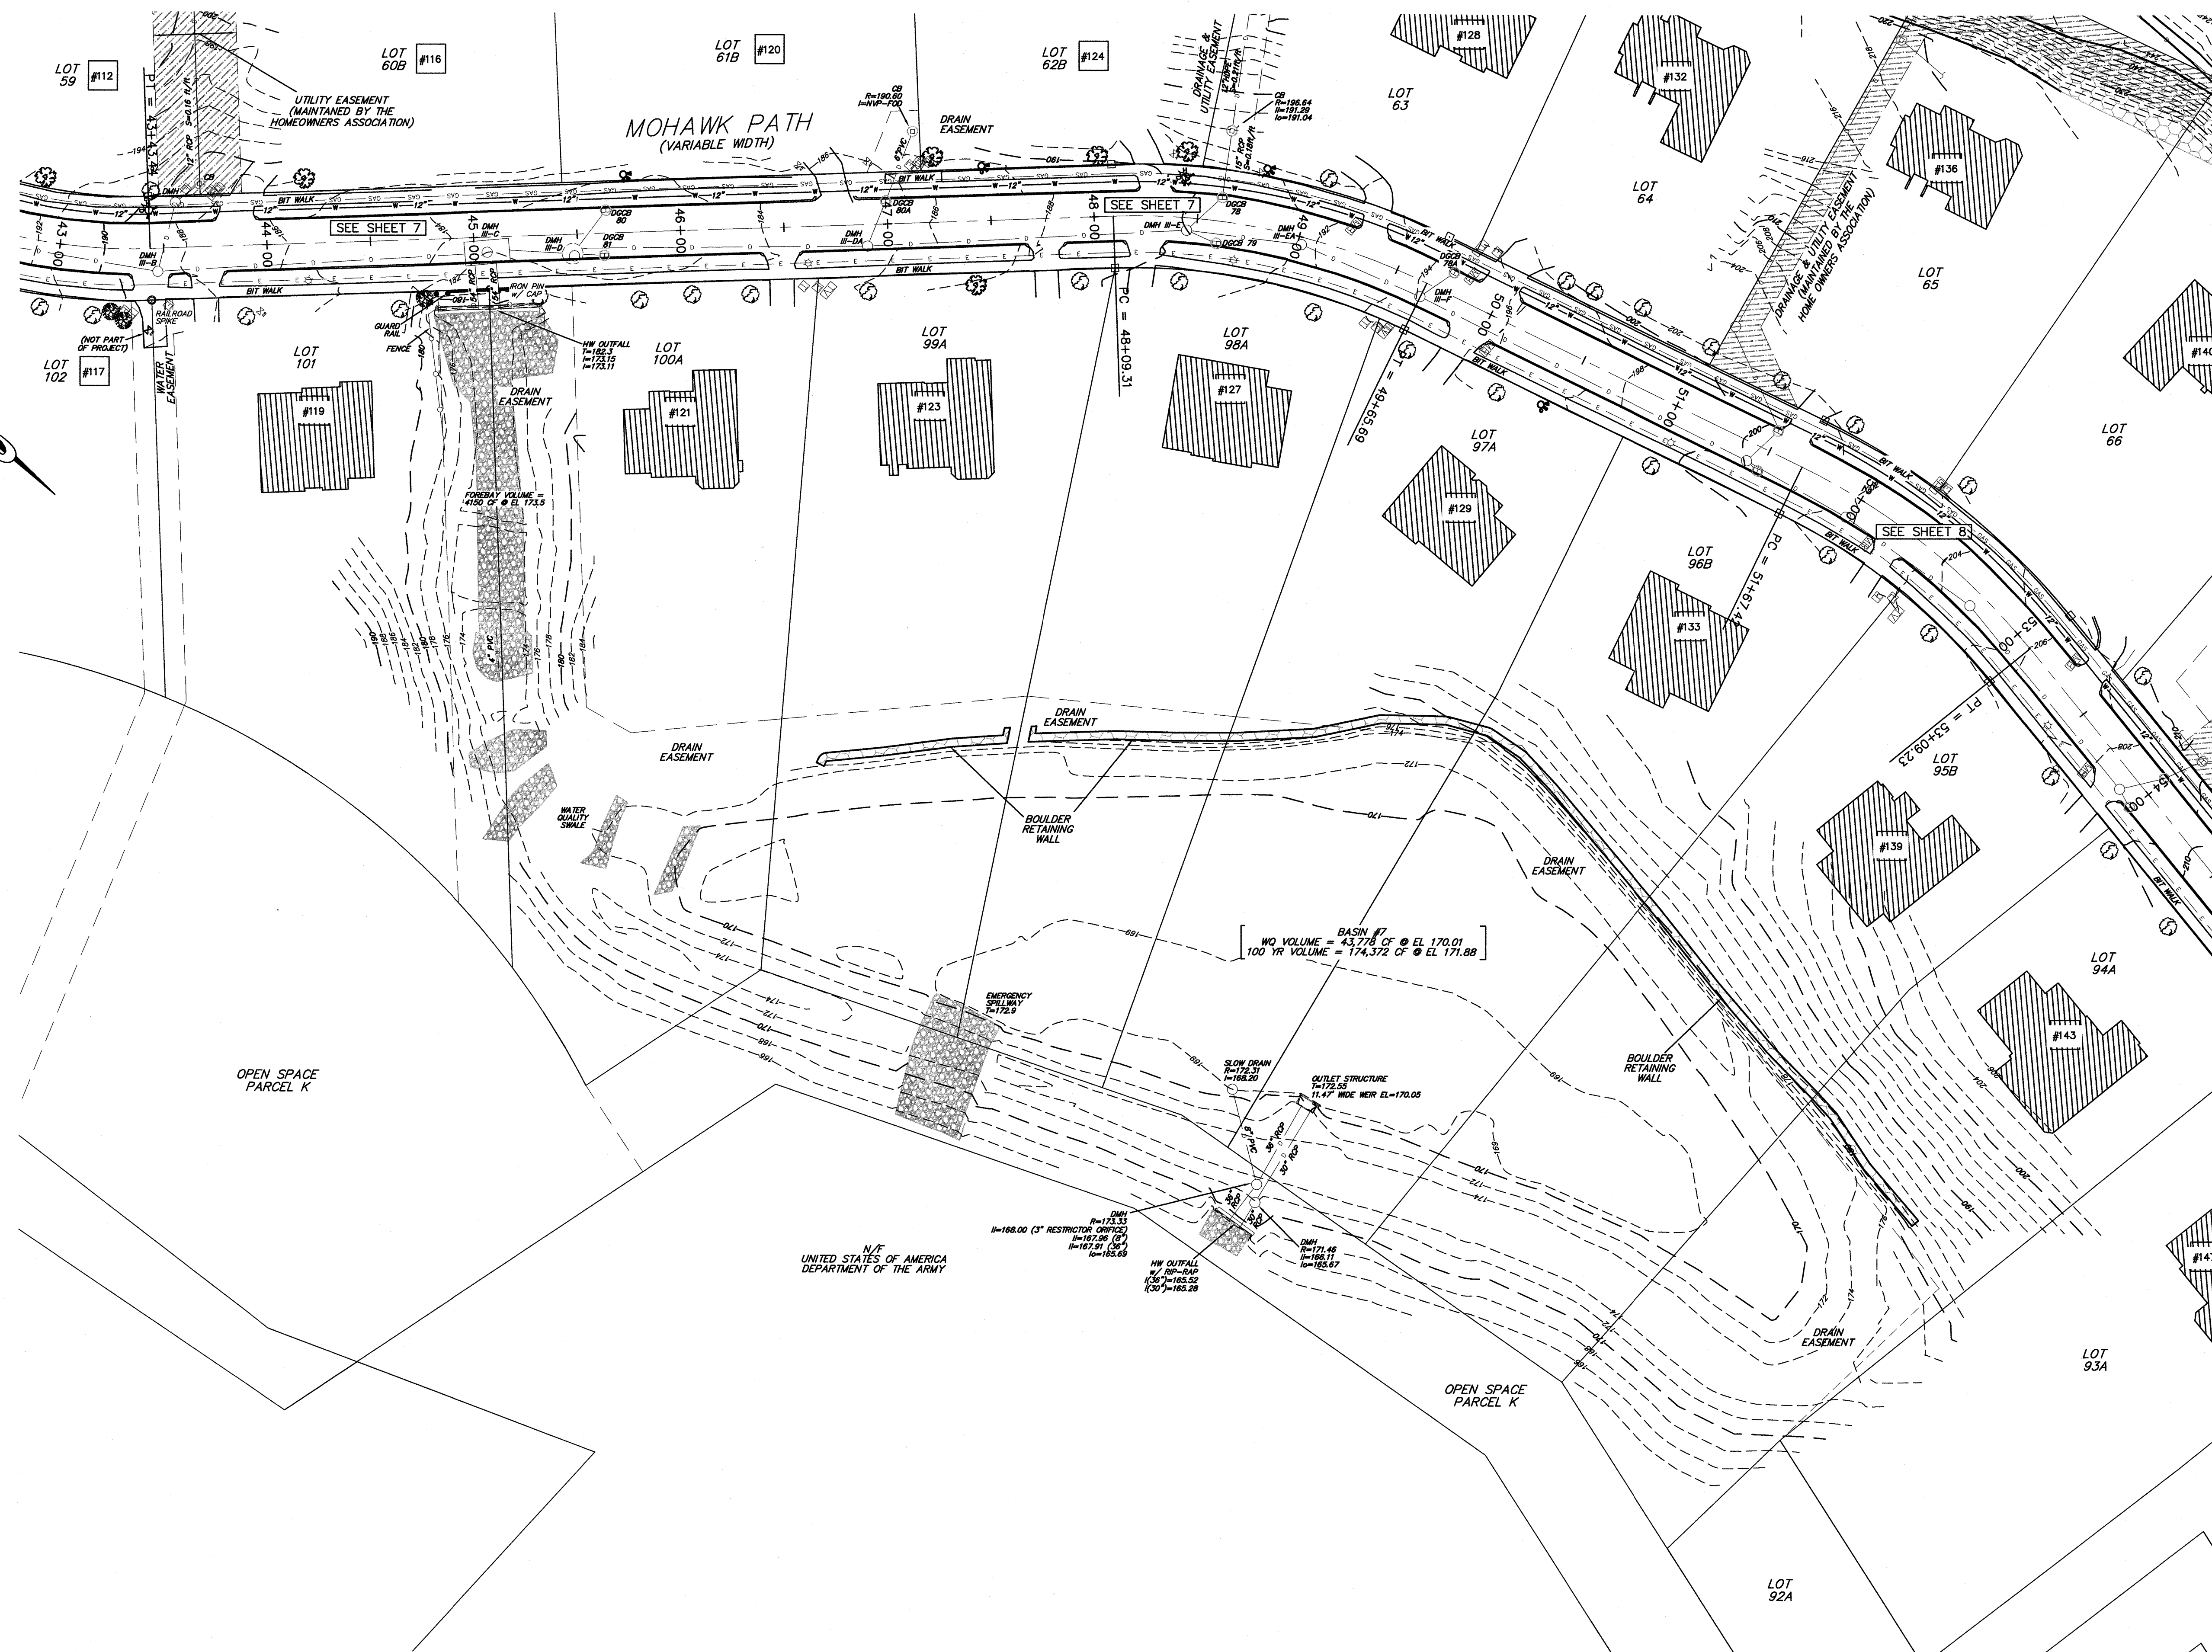



NOTE: CONSTRUCTION ON THIS PROJECT IS SUBJECT TO ANY EASEMENTS, RIGHTS-OF-WAY, RESTRICTIONS, RESERVATIONS OR OTHER LIMITATIONS WHICH MAY BE REVEALED BY AN EXAMINATION OF THE TITLE.

**DIG SAFE NOTE:**

UTILITIES ARE PLOTTED FROM FIELD LOCATION AND ANY RECORD INFORMATION AVAILABLE, AND SHOULD BE CONSIDERED APPROXIMATE. OTHER UTILITIES MAY EXIST WHICH ARE NOT EVIDENT OR FOR WHICH RECORD INFORMATION WAS NOT AVAILABLE. CONTRACTORS (IN ACCORDANCE WITH MASS.G.L. CHAPTER 82 SECTION 40 AS AMENDED) MUST CONTACT ALL UTILITY COMPANIES BEFORE EXCAVATING AND DRILLING. CALL "DIG-SAFE" AT 811.

EXISTING LINES OTHER THAN THOSE INDICATED ON THESE DRAWINGS MAY BE ON THE SITE. THE CONTRACTOR IS WARNED TO PROCEED WITH CAUTION WITH ALL WORK, ESPECIALLY EXCAVATION WORK, AND TO MAKE ALL POSSIBLE INVESTIGATIONS AS TO POSSIBLE UNMARKED UTILITY LINES.

NOTES

1. SEE PLAN NO. 1006 OF 1999 AND PLAN NO. 100 OF 2000 RECORDED AT THE MIDDLESEX SOUTH DISTRICT REGISTRY OF DEEDS.


OWNER:
HOLLISTON RESIDENTIAL REALTY, LLC
120 QUARRY DRIVE
MILFORD, MA 01757

"THE HIGHLANDS AT HOLLISTON"
INDIAN CIRCLE
MAYFLOWER LANDING
MOHAWK PATH

AS-BUILT PLAN AND PROFILE OF LAND
IN
Holliston, Massachusetts
SCALE: 40 FEET TO AN INCH HORIZONTAL
4 FEET TO AN INCH VERTICAL
DATE: JANUARY 6, 2017

REVISIONS			
NO.	DATE	DESCRIPTION	BY
1	06-15-17	03-17-17 PLANNER COMMENTS	FJO
2	09-24-18	REVIEW COMMENTS	FJO
3	08-20-19	REVIEW COMMENTS	FJO
4	01-24-20	EASEMENTS	FJO
5	10-15-20	PLANNER COMMENTS	FJO
6	01-21-21	MAYFLOWER WATER UTILITY PROPOSED UTILITY EASEMENT AT MAYFLOWER HON EASEMENTS	FJO

Guerriere & Halnon, Inc.
Engineering & Land Surveying
333 WEST STREET, MILFORD, MASS. 01757
(508) 473-6630 FAX: (508) 473-8243
www.gandhengineering.com

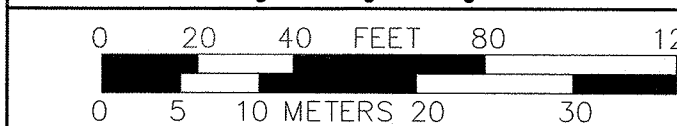

SHEET 13 OF 13
OPEN SPACE J DRAINAGE SWALE

FJO

