


No.	DATE	DESCRIPTION

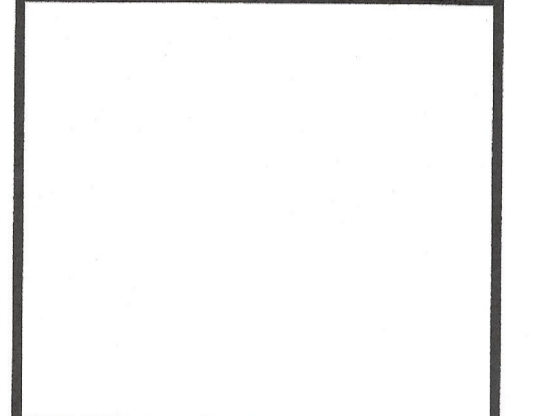

11/7/22

**SITE AS-BUILT PLAN
 SCOOPY TRUCK SALES
 1569 WASHINGTON STREET
 HOLLISTON, MASSACHUSETTS**

PREPARED FOR:
 MICHAEL ALVES
 1569 WASHINGTON STREET
 HOLLISTON, MA 01746

GLM Engineering
 Consultants, Inc.
 19 EXCHANGE STREET
 HOLLISTON, MA 01746
 P: 508-429-1100
 F: 508-429-7160
 www.GLMengineering.com

JOB No.: 12677 2022-ASB
 DATE: 11/7/2022
 SCALE: 1"=20'
 SHEET: 1 of 1
 PLAN #: 27,778