

## TOWN OF HOLLISTON ZONING BOARD OF APPEALS

HOLLISTON, MASSACHUSETTS 01748

## APPLICATION FOR GRANT OF A USE VARIANCE

Under the provisions of Section VI-D (3) to vary the terms of Section I-B and the following, the Applicant hereby petitions the Board of Appeals:


Nature :	and	subject	matter	of	Variance:
----------	-----	---------	--------	----	-----------

Front porch ( Need 3.2 Foot Vansure)
- Replace I broken Stairs + Added a Front Farmers Porch
Section of Zoning Bylaw that permits this use by grant of Variance:

rc 3.2

Zoning Information (To be completed by Inspector of Buildings):

A building permit was issued in July of 2020 to construct a rear addition and new front entry porch, which would have projected 5' from the front of the house (in conformance with the required 40' front setback.) Upon inspection, it was determined that the contractor did not follow the approved plan and increased the depth of the porch, pushing the structure beyond the 40' front yard setback. Either a variance must be granted to allow the new non-conforming structure to remain or the portion of the porch that extends into the setback must be removed. The property does not have unusual lot shape, topography or soil condition when compared to neighboring properties, and there is no substantial hardship since a conforming entry porch was designed and approved. CC 10/28/20

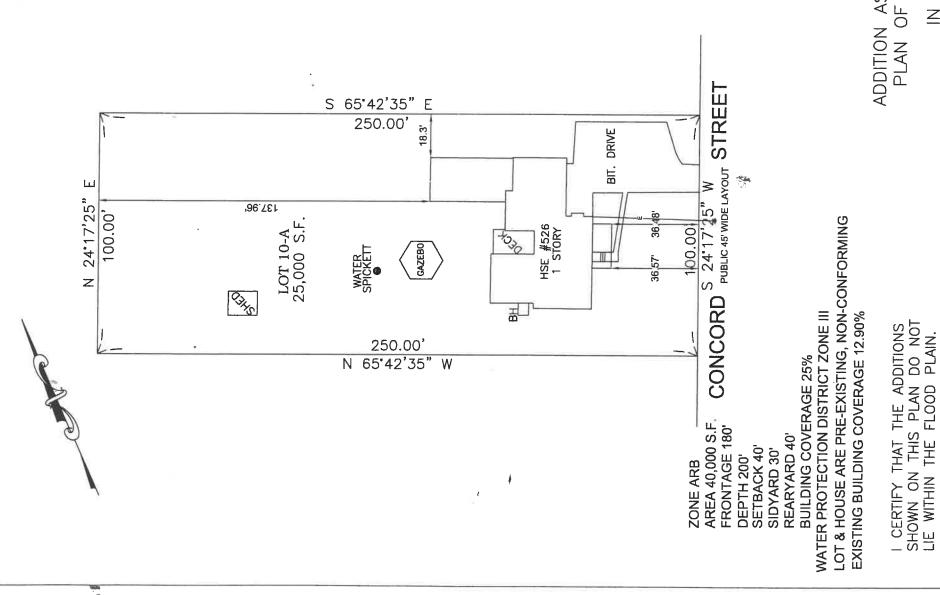

A.

ADDITION AS-BUILT PLAN OF LAND

## HOLLISTON, MA

14, 2020 SCALE:1"=40 OCT.

Intinarelli OWNER: Sandra C. Intina 526 Concord Streert Holliston, Ma. 01746 COLONIAL ENGINEERING INC. 11 AWL STREET MEDWAY, MA. 508-533-1644